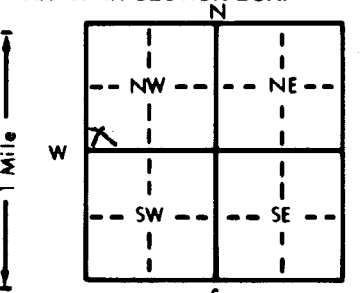


1 LOCATION OF WATER WELL: County: SCOTT		Fraction SW $\frac{1}{4}$ SW $\frac{1}{4}$ NE $\frac{1}{4}$	Section Number 24	Township Number T 17 S	Range Number R 32 E (W)
Distance and direction from nearest town or city street address of well if located within city? 5 miles East 5 $\frac{1}{2}$ miles North of Scott City, Kansas					
2 WATER WELL OWNER: RR#, St. Address, Box # : City, State, ZIP Code :		Griffith Cattle Co. 307 Alice Scott City, Kansas 67871 Board of Agriculture, Division of Water Resources Application Number: 38388			
3 LOCATE WELL'S LOCATION WITH AN "X" IN SECTION BOX: 		4 DEPTH OF COMPLETED WELL: 180 ft. ELEVATION: Depth(s) Groundwater Encountered 1. 123 ft. 2. ft. 3. ft. WELL'S STATIC WATER LEVEL 123 ft. below land surface measured on mo/day/yr 6/11/87 NA Pump test data: Well water was ft. after hours pumping gpm Est. Yield gpm: Well water was ft. after hours pumping gpm Bore Hole Diameter 9 in. to 180 ft. and in. to ft. WELL WATER TO BE USED AS: 5 Public water supply 8 Air conditioning 11 Injection well 1 Domestic 3 Feedlot 6 Oil field water supply 9 Dewatering 12 Other (Specify below) 2 Irrigation 4 Industrial 7 Lawn and garden only 10 Observation well Was a chemical/bacteriological sample submitted to Department? Yes No X ; If yes, mo/day/yr sample was submitted Water Well Disinfected? Yes X No			
5 TYPE OF BLANK CASING USED: 1 Steel 2 PVC Blank casing diameter 5 in. to 140 ft., Dia in. to ft., Dia in. to ft. Casing height above land surface 12 in., weight 2.9 lbs./ft. Wall thickness or gauge No. 265		5 Wrought iron 8 Concrete tile CASING JOINTS Glued Clamped 3 RMP (SR) 6 Asbestos-Cement 9 Other (specify below) Welded 4 ABS 7 Fiberglass Threaded TYPE OF SCREEN OR PERFORATION MATERIAL: 1 Steel 3 Stainless steel 5 Fiberglass 8 RMP (SR) 10 Asbestos-cement 2 Brass 4 Galvanized steel 6 Concrete tile 9 ABS 11 Other (specify) 12 None used (open hole) SCREEN OR PERFORATION OPENINGS ARE: 1 Continuous slot 3 Mill slot 5 Gauzed wrapped 8 Saw cut 11 None (open hole) 2 Louvered shutter 4 Key punched 6 Wire wrapped 9 Drilled holes 7 Torch cut 10 Other (specify) SCREEN-PERFORATED INTERVALS: From 140 ft. to 180 ft., From ft. to ft. From ft. to ft., From ft. to ft. GRAVEL PACK INTERVALS: From 100 ft. to 180 ft., From ft. to ft. From ft. to ft., From ft. to ft.			
6 GROUT MATERIAL: 1 Near cement 2 Cement grout 3 Bentonite 4 Other Drill cuttings Grout Intervals: From 25 ft. to 100 ft., From 4 ft. to 25 ft., From ft. to ft. What is the nearest source of possible contamination: 1 Septic tank 4 Lateral lines 7 Pit privy 10 Livestock pens 14 Abandoned water well 2 Sewer lines 5 Cess pool 8 Sewage lagoon 11 Fuel storage 15 Oil well/Gas well 3 Watertight sewer lines 6 Seepage pit 9 Feedyard 12 Fertilizer storage 16 Other (specify below) 13 Insecticide storage Direction from well? North How many feet? 50					
FROM TO LITHOLOGIC LOG		FROM TO LITHOLOGIC LOG			
0	24	Clay	24	49	Caliche
49	58	Fine sand	58	79	Sand
79	84	Caliche	84	111	Sand cemented
111	162	Fine sand	162	175	Sand fine to medium
175	180	Yellow clay			
7 CONTRACTOR'S OR LANDOWNER'S CERTIFICATION: This water well was (1) constructed , (2) reconstructed , or (3) plugged under my jurisdiction and was completed on (mo/day/year) 6/12/87 and this record is true to the best of my knowledge and belief. Kansas Water Well Contractor's License No. 232 This Water Well Record was completed on (mo/day/yr) 6/29/87 under the business name of Weishaar Drilling & Supply Inc. by (signature) <i>Ray Weishaar</i>					
INSTRUCTIONS: Use typewriter or ball point pen. PLEASE PRESS FIRMLY and PRINT clearly. Please fill in blanks, underline or circle the correct answers. Send top three copies to Kansas Department of Health and Environment, Bureau of Water Protection, Topeka, Kansas 66620-7320, Telephone: 913-862-9360. Send one to WATER WELL OWNER and retain one for your records.					