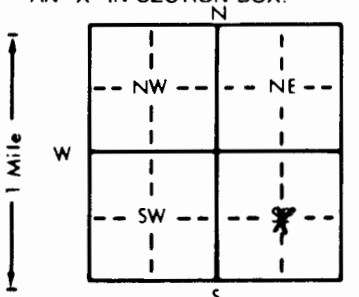


1 LOCATION OF WATER WELL:		Fraction	Section Number	Township Number	Range Number
County: Scott		1/4 NC XX SE 1/4	27	T 17 S	R 32 EW
Distance and direction from nearest town or city street address of well if located within city? 3/4 Mile South, 1/4 Mile West of Brookover Feedlot, Scott City, Kansas					
2 WATER WELL OWNER: Brookover Land & Cattle					
RR#, St. Address, Box #: Route 1, Box 98			Board of Agriculture, Division of Water Resources		
City, State, ZIP Code: Scott City, KS 67871			Application Number:		
3 LOCATE WELL'S LOCATION WITH AN "X" IN SECTION BOX:		4 DEPTH OF COMPLETED WELL: 176' ft. ELEVATION:			
		Depth(s) Groundwater Encountered 1. ft. 2. ft. 3. ft. WELL'S STATIC WATER LEVEL: 143' ft. below land surface measured on mo/day/yr 03/27/90 Pump test data: Well water was ft. after hours pumping gpm Est. Yield gpm: Well water was ft. after hours pumping gpm Bore Hole Diameter: in. to ft., and in. to ft. WELL WATER XXXX USED AS: 5 Public water supply 8 Air conditioning 11 Injection well 1 Domestic WAS 3 Feedlot 6 Oil field water supply 9 Dewatering 12 Other (Specify below) 2 Irrigation 4 Industrial 7 Lawn and garden only 10 Monitoring well Was a chemical/bacteriological sample submitted to Department? Yes.....No. X.....; If yes, mo/day/yr sample was submitted Water Well Disinfected? Yes X No			
5 TYPE OF BLANK CASING USED:					
1 Steel 2 PVC		3 RMP (SR) 4 ABS		5 Wrought iron 6 Asbestos-Cement 7 Fiberglass	
Blank casing diameter: 18" in. to 176' ft. Dia		8 Concrete tile 9 Other (specify below)		CASING JOINTS: Glued Clamped Welded Threaded	
Casing height above land surface: 3' Below in., weight lbs./ft. Wall thickness or gauge No.					
TYPE OF SCREEN OR PERFORATION MATERIAL:					
1 Steel 2 Brass		3 Stainless steel 4 Galvanized steel		5 Fiberglass 6 Concrete tile	
SCREEN OR PERFORATION OPENINGS ARE:		5 Gauzed wrapped 6 Wire wrapped 7 Torch cut		8 Saw cut 9 Drilled holes 10 Other (specify)	
1 Continuous slot 2 Louvered shutter		3 Mill slot 4 Key punched		11 None (open hole)	
SCREEN-PERFORATED INTERVALS: From ft. to ft., From ft. to ft. From ft. to ft., From ft. to ft. GRAVEL PACK INTERVALS: From ft. to ft., From ft. to ft. From ft. to ft., From ft. to ft.					
6 GROUT MATERIAL: 1 Neat cement 2 Cement grout 3 Bentonite 4 Other					
Grout Intervals: From 165' ft. to 162' ft., From 13' ft. to 3' ft., From ft. to ft.					
What is the nearest source of possible contamination:					
1 Septic tank 2 Sewer lines 3 Watertight sewer lines		4 Lateral lines 5 Cess pool 6 Seepage pit		7 Pit privy 8 Sewage lagoon 9 Feedyard	
10 Livestock pens 11 Fuel storage 12 Fertilizer storage 13 Insecticide storage		14 Abandoned water well 15 Oil well/Gas well 16 Other (specify below)		Direction from well? How many feet?	
FROM	TO	LITHOLOGIC LOG	FROM	TO	PLUGGING INTERVALS
			176'	143'	Chlorinated Sand & Gravel
			143'	140'	Bentonite Grout
			140'	13'	Compacted Inorganic Clays
			13'	3'	Bentonite Grout
			3'	0'	Top Soil
7 CONTRACTOR'S OR LANDOWNER'S CERTIFICATION: This water well was (1) constructed, (2) reconstructed, or (3) plugged under my jurisdiction and was completed on (mo/day/year) 06/20/90 and this record is true to the best of my knowledge and belief. Kansas Water Well Contractor's License No. 518 514 This Water Well Record was completed on (mo/day/yr) 06/22/90 under the business name of Miller Gearhead & Pump Repair, Inc. by (signature) Everett Miller					