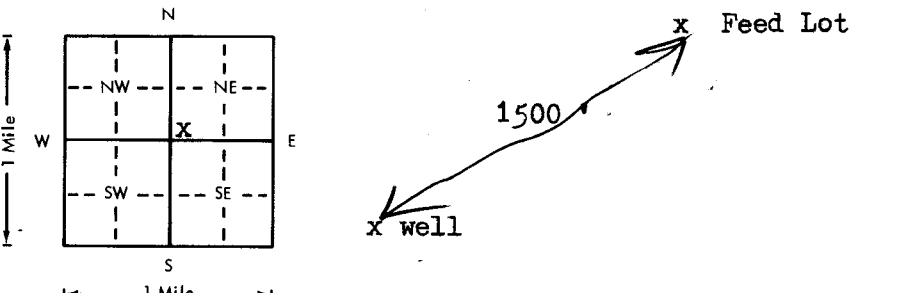


USE TYPEWRITER OR BALL
POINT PEN—PRESS FIRMLY,
PRINT CLEARLY.

WATER WELL RECORD
KSA 82a-1201-1215

Kansas Department of Health and
Environment—Division of Environment
(Water well Contractors)
Topeka, Kansas 66620

1. Location of well:		County Scott	Fraction SW 1/4 SW 1/4 NE 1/4	Section number 27	Township number T 17 S R 32	Range number E 4W
2. Distance and direction from nearest town or city: 5 N 3 1/2 E 1/2 S of Scott City Street address of well location if in city:			3. Owner of well: Brookover Cattle Co. R.R. or street: City, state, zip code: Scott City, Kansas 67871			
4. Locate with "X" in section below:		Sketch map:		6. Bore hole dia. 26 in. Completion date 4/24/79 Well depth 185 ft.		
				7. Cable tool <input type="checkbox"/> Rotary <input type="checkbox"/> Driven <input type="checkbox"/> Dug <input type="checkbox"/> Hollow rod <input type="checkbox"/> Jetted <input type="checkbox"/> Bored <input checked="" type="checkbox"/> Reverse rotary		
5. Type and color of material		From	To	8. Use: Domestic <input type="checkbox"/> Public supply <input type="checkbox"/> Industry <input checked="" type="checkbox"/> Irrigation <input type="checkbox"/> Air conditioning <input type="checkbox"/> Stock <input type="checkbox"/> Lawn <input type="checkbox"/> Oil field water <input type="checkbox"/> Other		
Clay		0	27	9. Casing: Material Steel Height: Above or below Threaded <input type="checkbox"/> Welded <input checked="" type="checkbox"/> Surface 10 in. RMP <input type="checkbox"/> PVC <input type="checkbox"/> Weight 3/62 lbs./ft. Dia. 16 in. to 155 ft. depth Wall thickness: inches or Dia. <input type="checkbox"/> in. to <input type="checkbox"/> ft. depth gage No. .188		
Gyp		27	45	10. Screen: Manufacturer's name Free Flow & Johnson Type galv. & prime steel 30" 16 Slot/gauze 100 Length 30 Set between 155 ft. and 175 ft. 175 ft. and 185 ft. Gravel pack? yes Size range of material 3/4 x 3/4		
clay sandy		45	54	11. Static water level: 135 ft. below land surface Date 3/14/79		
sand		54	110	12. Pumping level below land surfaces: 148 ft. after 8 hrs. pumping 420 g.p.m. 162 ft. after 8 hrs. pumping 570 g.p.m. Estimated maximum yield 600 g.p.m.		
clay		110	113	13. Water sample submitted: <input type="checkbox"/> Yes <input checked="" type="checkbox"/> No Date <input type="checkbox"/>		
rock		113	114	14. Well head completion: <input type="checkbox"/> Pitless adapter 10 inches above grade		
fine sand with clay streaks		114	140	15. Well grouted? yes With: <input type="checkbox"/> Neat cement <input type="checkbox"/> Bentonite <input checked="" type="checkbox"/> Concrete Depth: From 0 ft. to 15 ft.		
fine sand		140	167	16. Nearest source of possible contamination: ft. 1500 Direction NE Type Feed Lot Well disinfected upon completion? <input checked="" type="checkbox"/> Yes <input type="checkbox"/> No		
sand		167	179	17. Pump: <input type="checkbox"/> Not installed Manufacturer's name Peerless Model number <input type="checkbox"/> HP <input type="checkbox"/> Volts <input type="checkbox"/> Length of drop pipe 178 ft. capacity 500 g.p.m. Type: <input type="checkbox"/> Submersible <input checked="" type="checkbox"/> Turbine <input type="checkbox"/> Jet <input type="checkbox"/> Reciprocating <input type="checkbox"/> Centrifugal <input type="checkbox"/> Other		
clay yellow		179	185	20. Water well contractor's certification: This well was drilled under my jurisdiction and this report is true to the best of my knowledge and belief. Weishaar Drilling & Supply 232 Business name Scott City, Kansas 67871 License No. 72479 Address Scott City, Kansas 67871 Signed [Signature] Authorized representative		
shale		185				
(Use a second sheet if needed)						
18. Elevation:		19. Remarks:				
Topography: <input type="checkbox"/> Hill <input checked="" type="checkbox"/> Slope <input checked="" type="checkbox"/> Upland <input type="checkbox"/> Valley						

Forward the white, blue and pink copies to the Department of Health and Environment

Form WWC-5