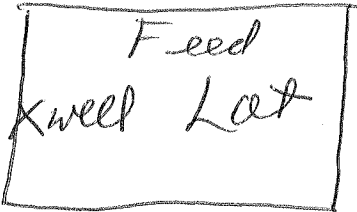


USE TYPEWRITER OR BALL POINT PEN-PRESS FIRMLY, PRINT CLEARLY.

WATER WELL RECORD
KSA 82a-1201-1215

Kansas Department of Health and Environment-Division of Environment (Water well Contractors) Topeka, Kansas 66620

1. Location of well:	County Scott	Fraction NW 1/4 SW 1/4 NE 1/4	Section number 31	Township number T 17 S R 33	Range number 33
2. Distance and direction from nearest town or city: 4N, 5 1/2W, 1/4S of Street address of well location if in city: Scott City, KS			3. Owner of well: Hess Bros. R.R. or street: RFD #3 City, state, zip code: Scott City, KS 67871		
4. Locate with "X" in section below: N W E S 1 Mile		Sketch map: 		6. Bore hole dia. <u>9</u> in. Completion date _____ Well depth <u>170</u> ft. <u>7-2-76</u>	
5. Type and color of material		From To		7. <input checked="" type="checkbox"/> Cable tool Rotary <input type="checkbox"/> Driven <input type="checkbox"/> Dug <input type="checkbox"/> Hollow rod <input type="checkbox"/> Jetted <input type="checkbox"/> Bored <input type="checkbox"/> Reverse rotary	
				8. Use: <input type="checkbox"/> Domestic <input type="checkbox"/> Public supply <input type="checkbox"/> Industry <input checked="" type="checkbox"/> Irrigation <input type="checkbox"/> Air conditioning <input checked="" type="checkbox"/> Stock <input type="checkbox"/> Lawn <input type="checkbox"/> Oil field water <input type="checkbox"/> Other	
Clay		0 20		9. Casing: Material <u>Plas.</u> Height: <u>Above</u> or below Threaded _____ Welded <u>Clue</u> Surface <u>12</u> in. RMP <input checked="" type="checkbox"/> PVC _____ Weight <u>1.8</u> lbs./ft. Dia. <u>5</u> in. to <u>150</u> ft. depth Wall Thickness: inches or Dia. _____ in. to _____ ft. depth gage No. <u>250</u>	
Gyp		20 30		10. Screen: Manufacturer's name <u>Jess & Lowell</u> Type <u>RMP</u> Dia. <u>5 in.</u> <input checked="" type="checkbox"/> Not gauze <u>1/16</u> Length <u>20 ft.</u> Set between <u>150</u> ft. and <u>170</u> ft. _____ ft. and _____ ft.	
Clay		30 34		Gravel pack? <u>yes</u> Size range of material <u>1/8-1/4</u>	
Sd coarse T		34 41		11. Static water level: _____ mo./day/yr. <u>118</u> ft. below land surface Date <u>6-24-76</u>	
Sd rock		41 47		12. Pumping level below land surfaces: <u>128</u> ft. after <u>1</u> hrs. pumping <u>18</u> g.p.m. _____ ft. after _____ hrs. pumping _____ g.p.m. Estimated maximum yield <u>18</u> g.p.m.	
Gyp		47 60		13. Water sample submitted: _____ mo./day/yr. Yes <input type="checkbox"/> No <input checked="" type="checkbox"/> Date _____	
Gyp & clay		60 69		14. Well head completion: <input checked="" type="checkbox"/> Pitless adapter <u>12</u> inches above grade	
Fine sd clay		69 115		15. Well grouted? <u>yes</u> With: <input checked="" type="checkbox"/> Neat cement _____ Bentonite _____ Concrete _____ Depth: From <u>0</u> ft. to <u>15</u> ft.	
Sd coarse		115 124		16. Nearest source of possible contamination: <u>In Feed</u> ft. _____ Direction _____ Type <u>Lot</u> Well disinfected upon completion? <input checked="" type="checkbox"/> Yes _____ No _____	
Fine sd		124 145		17. Pump: _____ Not installed Manufacturer's name <u>Red Jacket</u> Model number <u>20011</u> HP <u>2</u> Volts <u>220</u> Length of drop pipe <u>163</u> ft. capacity <u>18</u> g.p.m. Type: <input checked="" type="checkbox"/> Submersible _____ Turbine _____ Jet _____ Reciprocating _____ Centrifugal _____ Other _____	
Sd coarse		145 158		20. Water well contractor's certification: This well was drilled under my jurisdiction and this report is true to the best of my knowledge and belief. <u>Weishaar Drilling</u> <u>232</u> Business name _____ License No. _____ Address <u>Scott City, KS 67871</u> Signed <u>[Signature]</u> Date <u>7-22-76</u> Authorized representative <u>7-22-76</u>	
Clay yellow		165 170			
Shale		170			
(Use a second sheet if needed)					
18. Elevation: Topography: ____ Hill ____ Slope <input checked="" type="checkbox"/> Upland ____ Valley		19. Remarks:			

T 17 S R 33 E
Sec 31
1/4 1/4 1/4

Forward the white, blue and pink copies to the Department of Health and Environment

Form WWC-5