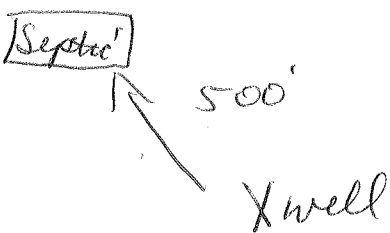


USE TYPEWRITER OR BALL POINT PEN-PRESS FIRMLY, PRINT CLEARLY.

WATER WELL RECORD
KSA 82a-1201-1215

Kansas Department of Health and Environment-Division of Environment (Water well Contractors) Topeka, Kansas 66620

1. Location of well:		County Scott	Fraction NW 1/4 NW 1/4 NW 1/4	Section number 32	Township number T 17 S R 33 E	Range number 33	
2. Distance and direction from nearest town or city: 5W, 4N of Street address of well location if in city: Scott City, KS				3. Owner of well: Norman Buehler R.R. or street: RFD #3 City, state, zip code: Scott City, KS 67871			
4. Locate with "X" in section below: N W E S 1 Mile				Sketch map: 		6. Bore hole dia. 26 in. Completion date _____ Well depth 181 ft. 3-29-75	
5. Type and color of material				7. <input type="checkbox"/> Cable tool <input type="checkbox"/> Rotary <input type="checkbox"/> Driven <input type="checkbox"/> Dug <input type="checkbox"/> Hollow rod <input type="checkbox"/> Jetted <input type="checkbox"/> Bored <input checked="" type="checkbox"/> Reverse rotary		8. Use: <input type="checkbox"/> Domestic <input type="checkbox"/> Public supply <input type="checkbox"/> Industry <input checked="" type="checkbox"/> Irrigation <input type="checkbox"/> Air conditioning <input type="checkbox"/> Stock <input type="checkbox"/> Lawn <input type="checkbox"/> Oil field water <input type="checkbox"/> Other	
				9. Casing: Material Steel Height: <input checked="" type="checkbox"/> Above <input type="checkbox"/> below Threaded _____ Welded <input checked="" type="checkbox"/> Surface 10 in. RMP _____ PVC _____ Weight 31.67 lbs./ft. Dia. 16 in. to 181 ft. depth Wall Thickness: inches or Dia. _____ in. to _____ ft. depth gage No. 188		10. Screen: Manufacturer's name _____ Free Flow Type Prime Steel Dia. 16 in. <input checked="" type="checkbox"/> gauze 125 Length 40 ft. Set between 141 ft. and 181 ft. _____ ft. and _____ ft. Gravel pack? <input checked="" type="checkbox"/> Yes Size range of material 3/4-1/2 ft.	
				11. Static water level: _____ mo./day/yr. 120 ft. below land surface Date 12-18-74		12. Pumping level below land surfaces: 136 ft. after 4 hrs. pumping 440 g.p.m. 148 ft. after 4 hrs. pumping 790 g.p.m. Estimated maximum yield 790 g.p.m.	
				13. Water sample submitted: _____ mo./day/yr. <input type="checkbox"/> Yes <input checked="" type="checkbox"/> No Date _____		14. Well head completion: <input checked="" type="checkbox"/> Pitless adapter _____ Inches above grade	
				15. Well grouted? _____ With: <input checked="" type="checkbox"/> Neat cement <input type="checkbox"/> Bentonite <input type="checkbox"/> Concrete Depth: From 0 ft. to 10 ft.		16. Nearest source of possible contamination: ft. 500 Direction NW Type Septic Well disinfected upon completion? <input checked="" type="checkbox"/> Yes <input type="checkbox"/> No	
				17. Pump: _____ Not installed Manufacturer's name Worthington Model number _____ HP _____ Volts _____ Length of drop pipe 180 ft. capacity 790 g.p.m. Type: <input type="checkbox"/> Submersible <input checked="" type="checkbox"/> Turbine <input type="checkbox"/> Jet <input type="checkbox"/> Reciprocating <input type="checkbox"/> Centrifugal <input type="checkbox"/> Other		20. Water well contractor's certification: This well was drilled under my jurisdiction and this report is true to the best of my knowledge and belief. Weishaar Drilling 232 Business name License No. Address Scott City, KS 67871 Signed <i>[Signature]</i> Date 7-19-76 Authorized representative	
18. Elevation:				19. Remarks:			
Topography: <input type="checkbox"/> Hill <input type="checkbox"/> Slope <input checked="" type="checkbox"/> Upland <input type="checkbox"/> Valley				(Use a second sheet if needed)			

Forward the white, blue and pink copies to the Department of Health and Environment

Form WW-5