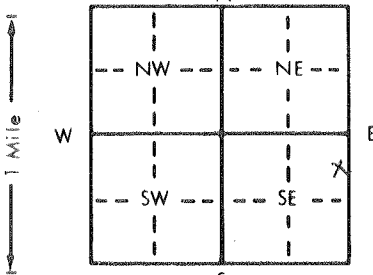


1 LOCATION OF WATER WELL: Fraction NE 1/4 NE 1/4 SE 1/4 Section Number 36 Township Number T 17 S Range Number R 33 **E/W**
 County: Scott Distance and direction from nearest town or city street address of well if located within city?

3 1/2 miles North of Scott City, Kansas

2 WATER WELL OWNER: Gordon Wiechman
 RR#, St. Address, Box #: R R 1 Board of Agriculture, Division of Water Resources
 City, State, ZIP Code: Scott City, Kansas 67871 Application Number:

3 LOCATE WELL'S LOCATION WITH AN "X" IN SECTION BOX:  4 DEPTH OF COMPLETED WELL... 235 ft. ELEVATION: ...
 Depth(s) Groundwater Encountered 1... 122 ft. 2... ft. 3... ft.
 WELL'S STATIC WATER LEVEL 122 ft. below land surface measured on mo/day/yr 5/26/82
 NA Pump test data: Well water was ... ft. after ... hours pumping ... gpm
 Est. Yield ... gpm: Well water was ... ft. after ... hours pumping ... gpm
 Bore Hole Diameter .9 in. to .235 ft., and ... in. to ... ft.
 WELL WATER TO BE USED AS: 5 Public water supply 8 Air conditioning 11 Injection well
 1 Domestic 3 Feedlot 6 Oil field water supply 9 Dewatering 12 Other (Specify below)
 2 Irrigation 4 Industrial 7 Lawn and garden only 10 Observation well
 Was a chemical/bacteriological sample submitted to Department? Yes... No... **X**...; If yes, mo/day/yr sample was submitted Water Well Disinfected? Yes **X** No

5 TYPE OF BLANK CASING USED: 5 Wrought iron 8 Concrete tile CASING JOINTS: **Glued** Clamped ...
 1 Steel 3 RMP (SR) 6 Asbestos-Cement 9 Other (specify below) Welded ...
 2 **PVC** 4 ABS 7 Fiberglass Threaded ...
 Blank casing diameter .5 in. to .215 ft., Dia ... in. to ... ft., Dia ... in. to ... ft.
 Casing height above land surface ... 12 in., weight ... 2.368 lbs./ft. Wall thickness or gauge No. .214 ...
 TYPE OF SCREEN OR PERFORATION MATERIAL: 7 **PVC** 10 Asbestos-cement
 1 Steel 3 Stainless steel 5 Fiberglass 8 RMP (SR) 11 Other (specify) ...
 2 Brass 4 Galvanized steel 6 Concrete tile 9 ABS 12 None used (open hole)
 SCREEN OR PERFORATION OPENINGS ARE: 5 Gauzed wrapped 8 **Saw cut** 11 None (open hole)
 1 Continuous slot 3 Mill slot 6 Wire wrapped 9 Drilled holes
 2 Louvered shutter 4 Key punched 7 Torch cut 10 Other (specify) ...
 SCREEN-PERFORATED INTERVALS: From ... 215 ft. to ... 235 ft., From ... ft. to ... ft.
 GRAVEL PACK INTERVALS: From ... 150 ft. to ... 235 ft., From ... ft. to ... ft.

6 GROUT MATERIAL: 1 **Neat cement** 2 Cement grout 3 Bentonite 4 **Other** Drill Cuttings ...
 Grout Intervals: From ... 15 ft. to ... 150 ft., From ... 4 ft. to ... 15 ft., From ... ft. to ... ft.
 What is the nearest source of possible contamination: 10 Livestock pens 14 Abandoned water well
 1 **Septic tank** 4 Lateral lines 7 Pit privy 11 Fuel storage 15 Oil well/Gas well
 2 Sewer lines 5 Cess pool 8 Sewage lagoon 12 Fertilizer storage 16 Other (specify below)
 3 Watertight sewer lines 6 Seepage pit 9 Feedyard 13 Insecticide storage ...
 Direction from well? **Southeast** How many feet? 150

FROM	TO	LITHOLOGIC LOG	FROM	TO	LITHOLOGIC LOG
0	75	Clay	75	81	Gyp
81	90	Clay	90	100	Fine sand clay streaks
100	110	Gyp	110	115	Clay
115	125	Fine sand clay streaks	125	152	Sand
152	185	Fine sand clay streaks	185	197	Medium sand
197	199	Fine Sand	199	203	Medium sand
203	209	Clay	209	212	Fine sand
212	215	Clay	215	222	Fine sand
222	227	Clay	227	231	Fine sand
231	233	Fine sand clay streaks	233	235	Yellow clay

7 CONTRACTOR'S OR LANDOWNER'S CERTIFICATION: This water well was **(1) constructed**, (2) reconstructed, or (3) plugged under my jurisdiction and was completed on (mo/day/year) ... 5/28/82 ... and this record is true to the best of my knowledge and belief. Kansas Water Well Contractor's License No. ... 232 ... This Water Well Record was completed on (mo/day/yr) ... under the business name of **Weishaar Drilling & Supply Inc.** by (signature) *David ...*

INSTRUCTIONS: Use typewriter or ball point pen, PLEASE PRESS FIRMLY and PRINT clearly. Please fill in blanks, underline or circle the correct answers. Send top three copies to Kansas Department of Health and Environment, Division of Environment, Environmental Geology Section, Topeka, KS 66620. Send one to WATER WELL OWNER and retain one for your records.