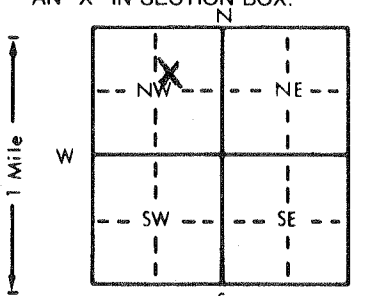


1 LOCATION OF WATER WELL: Fraction SW 1/4 NE 1/4 NW 1/4 Section Number 36 Township Number T 17 S Range Number R 33 E/W  
 County: Scott

Distance and direction from nearest town or city street address of well if located within city?

4 miles North 1/2 West of Scott City, KS

2 WATER WELL OWNER: Elma Parkinson  
 RR#, St. Address, Box # : 501 College Board of Agriculture, Division of Water Resources  
 City, State, ZIP Code : Scott City, KS 67871 Application Number: SC012

3 LOCATE WELL'S LOCATION WITH AN "X" IN SECTION BOX:  
  
 4 DEPTH OF COMPLETED WELL... 230 ft. ELEVATION: 3100  
 Depth(s) Groundwater Encountered 1... 182 ft. 2... ft. 3... ft.  
 WELL'S STATIC WATER LEVEL 182 ft. below land surface measured on mo/day/yr 4-16-92  
 Pump test data: Well water was 220 ft. after 4 hours pumping 500 gpm  
 Est. Yield 550 gpm: Well water was ft. after hours pumping gpm  
 Bore Hole Diameter... 26 in. to 230 ft., and in. to ft.  
 WELL WATER TO BE USED AS:  
 5 Public water supply 8 Air conditioning 11 Injection well  
 1 Domestic 3 Feedlot 6 Oil field water supply 9 Dewatering 12 Other (Specify below)  
2 Irrigation 4 Industrial 7 Lawn and garden only 10 Monitoring well  
 Was a chemical/bacteriological sample submitted to Department? Yes... No... X...; If yes, mo/day/yr sample was submitted  
 Water Well Disinfected? Yes X No

5 TYPE OF BLANK CASING USED:  
 1 Steel 3 RMP (SR) 5 Wrought iron 8 Concrete tile CASING JOINTS: Glued X Clamped  
 2 PVC 4 ABS 6 Asbestos-Cement 9 Other (specify below) Welded  
 7 Fiberglass Threaded  
 Blank casing diameter 16 in. to 190 ft., Dia. in. to ft., Dia. in. to ft.  
 Casing height above land surface 16 in., weight lbs./ft. Wall thickness or gauge No. sch 40  
 TYPE OF SCREEN OR PERFORATION MATERIAL:  
 1 Steel 3 Stainless steel 5 Fiberglass 7 PVC 10 Asbestos-cement  
 2 Brass 4 Galvanized steel 6 Concrete tile 8 RMP (SR) 11 Other (specify)  
 9 ABS 12 None used (open hole)  
 SCREEN OR PERFORATION OPENINGS ARE:  
 1 Continuous slot 3 Mill slot 5 Gauzed wrapped 8 Saw cut 11 None (open hole)  
 2 Louvered shutter 4 Key punched 6 Wire wrapped 9 Drilled holes  
 7 Torch cut 10 Other (specify)  
 SCREEN-PERFORATED INTERVALS: From 190 ft. to XXX 230 ft., From ft. to ft.  
 From ft. to ft., From ft. to ft.  
 GRAVEL PACK INTERVALS: From 20 ft. to 230 ft., From ft. to ft.  
 From ft. to ft., From ft. to ft.

6 GROUT MATERIAL: 1 Neat cement 2 Cement grout 3 Bentonite 4 Other  
 Grout Intervals: From 0 ft. to 20 ft., From ft. to ft., From ft. to ft.  
 What is the nearest source of possible contamination:  
 1 Septic tank 4 Lateral lines 7 Pit privy 10 Livestock pens 14 Abandoned water well  
 2 Sewer lines 5 Cess pool 8 Sewage lagoon 11 Fuel storage 15 Oil well/Gas well  
 3 Watertight sewer lines 6 Seepage pit 9 Feedyard 12 Fertilizer storage 16 Other (specify below)  
 13 Insecticide storage  
 Direction from well? north How many feet? 290

FROM	TO	LITHOLOGIC LOG	FROM	TO	PLUGGING INTERVALS
0	16	top soil & clay	180	190	sand (fine to medium)
16	32	sandy clay	190	196	sandy clay
32	55	grey clay	196	213	sand (fine to medium) 2ft clay
55	60	sand	213	222	sand (fine to medium)
60	65	sandy clay	222	228	yellow clay
65	82	limestone & sandy clay	228	230	shale
82	98	limestone & little clay			
98	110	sandy clay			
110	114	sand			
114	132	sand & little cemented sand			
132	142	limestone & little sand			
142	147	limestone (very very hard)			
147	159	limestone			
159	164	sand (medium)			
164	180	sand (fine to medium) 2ft clay			

7 CONTRACTOR'S OR LANDOWNER'S CERTIFICATION: This water well was (1) constructed, (2) reconstructed, or (3) plugged under my jurisdiction and was completed on (mo/day/year) 4-16-92 and this record is true to the best of my knowledge and belief. Kansas Water Well Contractor's License No. 473 This Water Well Record was completed on (mo/day/yr) 4-27-92 under the business name of Tyler Water Well Service by (signature) [Signature]

INSTRUCTIONS: Use typewriter or ball point pen. PLEASE PRESS FIRMLY and PRINT clearly. Please fill in blanks, underline or circle the correct answers. Send top three copies to Kansas Department of Health and Environment, Bureau of Water, Topeka, Kansas 66620-0001. Telephone: 913-296-5545. Send one to WATER WELL OWNER and retain one for your records.

99128190188