


1 LOCATION OF WATER WELL: Fraction SW 1/4 SW 1/4 NE 1/4 Section Number 6 Township Number T 17 S Range Number R 34 EAW  
 County: Scott  
 Distance and direction from nearest town or city street address of well if located within city?

1 1/2 miles West 8 1/2 North of Scott City, Kansas

2 WATER WELL OWNER: Galen Decker  
 RR#, St. Address, Box #: RFD # 3 Board of Agriculture, Division of Water Resources  
 City, State, ZIP Code: Scott City, Kansas 67871 Application Number: 35166

3 LOCATE WELL'S LOCATION WITH AN "X" IN SECTION BOX:

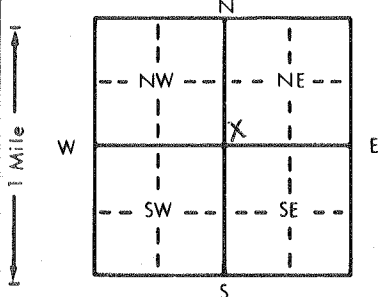

4 DEPTH OF COMPLETED WELL: 198 ft. ELEVATION: \_\_\_\_\_ ft.

Depth(s) Groundwater Encountered 1. 150 ft. 2. \_\_\_\_\_ ft. 3. \_\_\_\_\_ ft.  
 WELL'S STATIC WATER LEVEL 150 ft. below land surface measured on mo/day/yr 7/8/83.  
 Pump test data: Well water was 172 ft. after 4 hours pumping 420 gpm  
 Est. Yield 600 gpm: Well water was 181 ft. after 8 hours pumping 600 gpm  
 Bore Hole Diameter: 26 in. to 198 ft., and \_\_\_\_\_ in. to \_\_\_\_\_ ft.  
 WELL WATER TO BE USED AS:  
 1 Domestic  2 Irrigation  3 Feedlot  4 Industrial  5 Public water supply  6 Oil field water supply  7 Lawn and garden only  8 Air conditioning  9 Dewatering  10 Observation well  11 Injection well  12 Other (Specify below) \_\_\_\_\_  
 Was a chemical/bacteriological sample submitted to Department? Yes \_\_\_\_\_ No  If yes, mo/day/yr sample was submitted \_\_\_\_\_  
 Water Well Disinfected? Yes  No \_\_\_\_\_

5 TYPE OF BLANK CASING USED:  
 1 Steel  2 PVC  3 RMP (SR)  4 ABS  5 Wrought iron  6 Asbestos-Cement  7 Fiberglass  8 Concrete tile  9 Other (specify below) \_\_\_\_\_  
 CASING JOINTS: Glued \_\_\_\_\_ Clamped \_\_\_\_\_ Welded  Threaded \_\_\_\_\_

Blank casing diameter 16 in. to 168 ft., Dia \_\_\_\_\_ in. to \_\_\_\_\_ ft., Dia \_\_\_\_\_ in. to \_\_\_\_\_ ft.  
 Casing height above land surface 12 in., weight 36.87 lbs./ft. Wall thickness or gauge No. 219

TYPE OF SCREEN OR PERFORATION MATERIAL:  
 1 Steel  2 Brass  3 Stainless steel  4 Galvanized steel  5 Fiberglass  6 Concrete tile  7 PVC  8 RMP (SR)  9 ABS  10 Asbestos-cement  11 Other (specify) \_\_\_\_\_  
 12 None used (open hole) \_\_\_\_\_

SCREEN OR PERFORATION OPENINGS ARE:  
 1 Continuous slot  2 Louvered shutter  3 Mill slot  4 Key punched  5 Gauzed wrapped  6 Wire wrapped  7 Torch cut  8 Saw cut  9 Drilled holes  10 Other (specify) Extruded Bridge Type \_\_\_\_\_  
 11 None (open hole) \_\_\_\_\_

SCREEN-PERFORATED INTERVALS: From 168 ft. to 188 (EBT) ft., From \_\_\_\_\_ ft. to \_\_\_\_\_ ft.  
 From 188 ft. to 198 (WB) ft., From \_\_\_\_\_ ft. to \_\_\_\_\_ ft.  
 GRAVEL PACK INTERVALS: From 15 ft. to 198 ft., From \_\_\_\_\_ ft. to \_\_\_\_\_ ft.  
 From \_\_\_\_\_ ft. to \_\_\_\_\_ ft., From \_\_\_\_\_ ft. to \_\_\_\_\_ ft.

6 GROUT MATERIAL: 1 Neat cement  2 Cement grout  3 Bentonite  4 Other \_\_\_\_\_  
 Grout Intervals: From 0 ft. to 15 ft., From \_\_\_\_\_ ft. to \_\_\_\_\_ ft., From \_\_\_\_\_ ft. to \_\_\_\_\_ ft.

What is the nearest source of possible contamination:  
 1 Septic tank  2 Sewer lines  3 Watertight sewer lines  4 Lateral lines  5 Cess pool  6 Seepage pit  7 Pit privy  8 Sewage lagoon  9 Feedyard  10 Livestock pens  11 Fuel storage  12 Fertilizer storage  13 Insecticide storage  14 Abandoned water well  15 Oil well/Gas well  16 Other (specify below) \_\_\_\_\_  
 Direction from well? East How many feet? 2600

FROM	TO	LITHOLOGIC LOG	FROM	TO	LITHOLOGIC LOG
0	3	Surface	3	34	Clay
34	76	Sandy gravel & <del>wt</del> caliche	76	82	Hard sandy clay
82	106	Sand & gravel	106	118	Cemented sand
118	128	Sand & gravel Cemented streaks	128	160	Fine sand cemented streaks
160	182	Fine to medium sand	182	194	Sand & gravel
194	196	Clay yellow	196	198	Shale

7 CONTRACTOR'S OR LANDOWNER'S CERTIFICATION: This water well was (1) constructed, (2) reconstructed, or (3) plugged under my jurisdiction and was completed on (mo/day/year) 7/16/83 and this record is true to the best of my knowledge and belief. Kansas Water Well Contractor's License No. 232 This Water Well Record was completed on (mo/day/yr) 7/26/83 under the business name of Weishaar Drilling & Supply Inc. by (signature) \_\_\_\_\_

INSTRUCTIONS: Use typewriter or ball point pen, PLEASE PRESS FIRMLY and PRINT clearly. Please fill in blanks, underline or circle the correct answers. Send top three copies to Kansas Department of Health and Environment, Division of Environment, Environmental Geology Section, Topeka, KS 66620. Send one to WATER WELL OWNER and retain one for your records.