



USE TYPEWRITER OR BALL POINT PEN-PRESS FIRMLY, PRINT CLEARLY.

PENSE SE

173409A
T R EW sec 1/4 1/4 1/4 No.

BDA


WATER WELL RECORD
KSA 82a-1201-1215

Kansas State Dept. Of Health
(Water Well Contractors)
Forbes-Bldg. 740
Topeka, Kansas 66620

NE-SE-MW

| | | | | | | |
|---------------------|-----------------|-------------------------|--------------------------|------------------------------------|-------------------------------------|----------------------|
| 1 Location of well: | County Scott | Township name Beaver | Fraction CS 1/2 N 1/2 | Section number 9- 20 | Town number T17- 25 S | Range number R34W |
|---------------------|-----------------|-------------------------|--------------------------|------------------------------------|-------------------------------------|----------------------|

| | | | |
|--|--------------------------|------------------------------|------------------------------------|
| Distance and direction from nearest town or city: Street address of well location if in city: | 10W, 7N of Scott City | 3 Owner of well: Address: | Galen Decker Scott City, Kansas |
|--|--------------------------|------------------------------|------------------------------------|

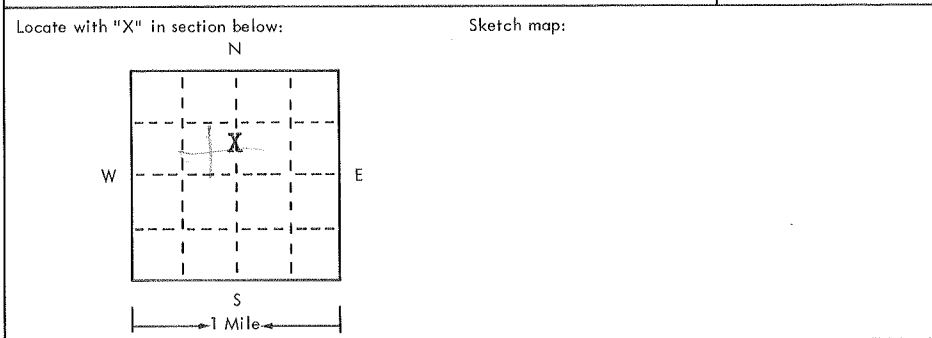

4 Well depth: 189 ft. Date of completion 3-5-75
Well diameter 9 in.

5 Cable tool Rotary Driven Dug
 Hollow rod Jetted Bored Reverse rotary

6 Use: Domestic Public supply Industry
 Irrigation Air conditioning Commercial
 Test well

7 Casing: Material Plastic Height: above/below
Threaded Welded Surface 12 in.
Diam. 5 in. to 189 ft. depth Drive shoe? Yes No
5 in. to 189 ft. depth Weight 1 1/2 lbs./ft. 1

| 2 | Type and color of material | From | To |
|---|----------------------------|------|-----|
| | Gyp | 0 | 14 |
| | Gyp | 14 | 28 |
| | Fine Sand | 28 | 36 |
| | Gyp and some hard sand | 36 | 60 |
| | Hard sand | 60 | 80 |
| | Fine sand | 80 | 100 |
| | Fine sand | 100 | 114 |
| | Sandy clay | 114 | 122 |
| | Fine sand | 122 | 134 |
| | Fine sand, fairly loose | 134 | 153 |
| | Sandy clay | 153 | 165 |
| | Clay | 165 | 169 |
| | Clay and sand | 169 | 175 |
| | Clay and gravel | 175 | 189 |
| | <u>BROCK 189'</u> | | |

8 Screen:
Manufacturer J & L Plastic
Type Plastic Dia. 5"
Slot/gauze 1/8" Length 20"
Set between 169 ft. and 189 ft.
Fittings:
Gravel pack Yes No Size range of material 1/2

9 Static water level:
100 ft. below land surface Date 3-5-75

10 Pumping level below land surfaces:
____ ft. after ____ hrs. pumping ____ g.p.m.
____ ft. after ____ hrs. pumping ____ g.p.m.
Estimated maximum yield 400 g.p.m.

11 Water sample submitted:
 Yes No Date _____

12 Well head completion:
 Pitless adapter Inches above grade

13 Well grouted? Yes No
 Neat cement Bentonite _____
Depth: From 0 ft. to 20 ft.

14 Nearest source of possible contamination: Feed Lot
ft. 1500 Direction _____ Type Lot
Well disinfected upon completion? Yes No

15 Pump: Not installed
Manufacturer's name _____
Model number _____ HP _____ Volts _____
Length of drop pipe _____ ft. capacity _____ g.m.p.
Type:
 Submersible Turbine
 Jet Reciprocating
 Centrifugal Other

16 Remarks: elevation 3134 (TOPO)

Topography:
 Hill Hilly
 Slope
 Upland
 Valley

17 Water well contractor's certification:
This well was drilled under my jurisdiction and this report is true to the best of my knowledge and belief.
Business name License No.
Address Scott City, Kansas
Signed Galen Decker
Authorized representative 3-13-75

Forward the white, blue and pink copies to the Kansas State Dept. Of Health.

Form WWC-5