


WATER WELL RECORD Form WWC-5 KSA 82a-1212

1 LOCATION OF WATER WELL: Fraction Section Number Township Number Range Number
 COUNTY: 086 SCOTT NW 1/4 SW 1/4 NE 1/4 16 T 17 S R 34 N

Distance and direction from nearest town or city street address of well if located within city?
 APPROX. 5 3/4 MILES NORTH OF MODOC.

2 WATER WELL OWNER: BERNARD NELSON Board of Agriculture, Division of Water Resources
 RR#, St. Address, Box #: 310 E. 6TH
 City, State, ZIP code: SCOTT CITY, KS 67871- Application Number: 332&25,004

3 LOCATE WELL'S LOCATION WITH AN "X" IN SECTION BOX:

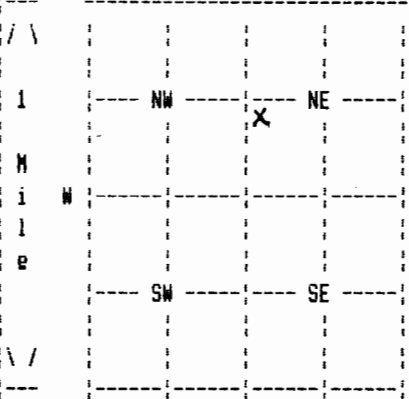

4 DEPTH OF COMPLETED WELL 210 ELEVATION: 0
 Depth(s) Groundwater Encountered 1. 164 ft. 2. 0 ft. 3. 0 ft.
 WELL'S STATIC WATER LEVEL 164 ft. below land surface measured on mo/day/yr 07/29/91
 Pump test data: Well water was 201 ft. after 4 hours pumping 125 gpm
 Estimated Yield 100 gpm: Well water was 0 ft. after 0 hours pumping 0 gpm
 Bore Hole Diameter 24 in. to 210 ft., and in. to 0 ft.
 WELL WATER TO BE USED AS: 02 IRRIGATION
 Was a chemical/bacteriological sample submitted to department? No;
 If yes, mo/day/yr sample was submitted Water well disinfected? No

5 TYPE OF BLANK CASING USED: 01 STEEL CASING JOINTS: WELDED
 Blank casing diameter 16 in. to 210 ft., Dia in. to 0 ft., Dia in. to 0 ft.
 Casing height above land surface 12 in., weight 0 lbs/ft. Wall thickness or gauge No.
 TYPE OF SCREEN OR PERFORATION MATERIAL: 01 STEEL
 SCREEN OR PERFORATION OPENINGS ARE: 01 CONT. SLOT

SCREEN PERFORATED INTERVALS: From 152 ft. to 172 ft., From 0 ft. to 0 ft.
 From 180 ft. to 200 ft., From 0 ft. to 0 ft.
 GRAVEL PACK INTERVALS: From 20 ft. to 210 ft., From 0 ft. to 0 ft.
 From 0 ft. to 0 ft., From 0 ft. to 0 ft.

6 GROUT MATERIAL 03 BENTONITE
 Grout Intervals: From 0 ft. to 20 ft., From 0 ft. to 0 ft., From 0 ft. to 0 ft.
 What is the nearest source of possible contamination: 14 ABAND. WELL
 Direction from well? NORTH How many feet? 100

FROM	TO	LITHOLOGIC LOG	FROM	TO	PLUGGING INTERVALS
0	2	01 CLAY			
2	26	01 CLAY 03 SILTY CLAY 07 FINE SAND			
26	40	01 CLAY 05 SAND			
40	50	07 FINE SAND 08 MEDIUM SAND 01 CLAY			
50	84	23 SANDSTONE 13 FINE GRAVEL 05 SAND			
84	90	04 SANDY CLAY			
90	102	07 FINE SAND 08 MEDIUM SAND			
102	110	07 FINE SAND 08 MEDIUM SAND			
110	124	23 SANDSTONE 05 SAND			
124	130	01 CLAY			

7 CONTRACTOR'S OR LANDOWNER'S CERTIFICATION: This water well was Constructed under my jurisdiction and was completed on (mo/day/year) 07/26/91 and this record is true to the best of my knowledge and belief. Kansas Water Well Contractor's License No. 145 This Water Well Record was completed on (mo/day/yr) 11/06/91 under the business name of HENKLE DRILLING & SUPPLY by (signature) *Douglas A. Henkle*

(Continued)

WATER WELL RECORD Form WWC-5 KSA 82a-1212

1 LOCATION OF WATER WELL: Fraction Section Number Township Number Range Number
COUNTY: 086 SCOTT NW 1/4 SW 1/4 NE 1/4 16 T 17 S R 34 W

2 WATER WELL OWNER: BERNARD NELSON Board of Agriculture, Division of Water Resources
RR#, St. Address, Box #: 310 E. 6TH

City, State, ZIP code : SCOTT CITY, KS 67871- Application Number: 332&25,004

FROM	TO	LITHOLOGIC LOG
130	172	07 FINE SAND 08 MEDIUM SAND 04 SANDY CLAY
172	180	01 CLAY
180	200	07 FINE SAND 08 MEDIUM SAND 09 COARSE SAND
200	201	19 SHALE
201	210	19 SHALE

7 CONTRACTOR'S OR LANDOWNER'S CERTIFICATION: This water well was Constructed under my jurisdiction and was completed on (mo/day/year) 07/26/91 and this record is true to the best of my knowledge and belief. Kansas Water Well Contractor's License No. 145 This Water Well Record was completed on (mo/day/yr) 11/06/91 under the business name of HENKLE DRILLING & SUPPLY by (signature) *Douglas R. Henkle*