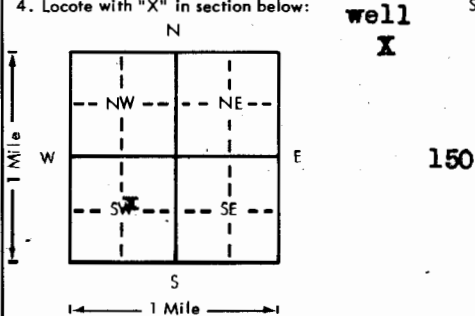


USE TYPEWRITER OR BALL POINT PEN-PRESS FIRMLY, PRINT CLEARLY.

WATER WELL RECORD
KSA 82a-1201-1215

Kansas Department of Health and Environment-Division of Environment (Water well Contractors) Topeka, Kansas 66620

CAL

1. Location of well:		County Scott	Fraction S/W 1/4 N/E 1/4 S/W 1/4	Section number 17	Township number T 17 S R 34 #/W	Range number
2. Distance and direction from nearest town or city: 6 1/2 N., 1 1/2 W., 1/4 S. of Modoc, Kansas Street address of well location if in city:			3. Owner of well: Larry Decker R.R. or street: RFD #3 City, state, zip code: SCOTT CITY, KANSAS 67871			
4. Locate with "X" in section below: well X Sketch map:  150' Septic X			6. Bore hole dia. 9 in. Completion date Well depth 122 ft. 8/31/1978		7. <input checked="" type="checkbox"/> Cable tool <input checked="" type="checkbox"/> Rotary <input type="checkbox"/> Driven <input type="checkbox"/> Dug <input type="checkbox"/> Hollow rod <input type="checkbox"/> Jetted <input type="checkbox"/> Bored <input type="checkbox"/> Reverse rotary	
5. Type and color of material			8. Use: <input checked="" type="checkbox"/> Domestic <input type="checkbox"/> Public supply <input type="checkbox"/> Industry <input type="checkbox"/> Irrigation <input type="checkbox"/> Air conditioning <input type="checkbox"/> Stock <input type="checkbox"/> Lawn <input type="checkbox"/> Oil field water <input type="checkbox"/> Other		9. Casing: Material Plastic Height: Above or below Threaded <input type="checkbox"/> Welded glue Surface 12 in. RMP <input checked="" type="checkbox"/> PVC <input type="checkbox"/> Weight 1.8 lbs./ft. Dia. 5 in. to 102 ft. depth Wall Thickness: inches or Dia. <input type="checkbox"/> in. to <input type="checkbox"/> ft. depth gage No. 250	
			10. Screen: Manufacturer's name Jess & Lowell Type RMP Dia. 5" Slot/gauze 1/16" Length 20' Set between 102 ft. and 122 ft. ft. and <input type="checkbox"/> ft. Gravel pack? yes Size range of material <input checked="" type="checkbox"/> 1/8"		11. Static water level: <input type="checkbox"/> mo./day/yr. 51 ft. below land surface Date 8/28/78	
			12. Pumping level below land surfaces: 60 ft. after 1 hrs. pumping 10 g.p.m. ft. after <input type="checkbox"/> hrs. pumping <input type="checkbox"/> g.p.m. Estimated maximum yield 10 g.p.m.		13. Water sample submitted: <input type="checkbox"/> mo./day/yr. <input type="checkbox"/> Yes <input checked="" type="checkbox"/> No Date	
			14. Well head completion: <input checked="" type="checkbox"/> Pitless adapter 12 Inches above grade		15. Well grouted? yes With: <input checked="" type="checkbox"/> Neat cement <input type="checkbox"/> Bentonite <input type="checkbox"/> Concrete Depth: From 0 ft. to 15 ft.	
			16. Nearest source of possible contamination: ft. 150 Direction S/R Type Septic Well disinfected upon completion? <input checked="" type="checkbox"/> Yes <input type="checkbox"/> No		17. Pump: <input type="checkbox"/> Not installed Manufacturer's name Gould Model number <input type="checkbox"/> HP 1 Volts 230 Length of drop pipe 118 ft. capacity 10 g.p.m. Type: <input checked="" type="checkbox"/> Submersible <input type="checkbox"/> Turbine <input type="checkbox"/> Jet <input type="checkbox"/> Reciprocating <input type="checkbox"/> Centrifugal <input type="checkbox"/> Other	
18. Elevation:			19. Remarks: Block 121 51 70 cut - floor		20. Water well contractor's certification: This well was drilled under my jurisdiction and this report is true to the best of my knowledge and belief. Weighear Drilling & Sup. 232 Business name License No. Address Scott City, KS 67871 Signature <i>[Signature]</i> Date 8/7/78 Authorized representative	
Topography: <input type="checkbox"/> Hill <input checked="" type="checkbox"/> Slope <input type="checkbox"/> Upland <input type="checkbox"/> Valley			(Use a second sheet if needed)			

T 17 R 34 E 17 Sec 34 SW 1/4 1/4 1/4

Forward the white, blue and pink copies to the Department of Health and Environment

Form WWLC-5