

USE TYPEWRITER OR BALL POINT PEN—PRESS FIRMLY, PRINT CLEARLY.

WATER WELL RECORD
KSA 82a-1201-1215


Kansas Department of Health and Environment—Division of Environment
(Water well Contractors)
Topeka, Kansas 66620

1. Location of well:		County Scott	Fraction NW 1/4 SE 1/4 SE 1/4	Section number 21	Township number T 17 S R 34 E 4	Range number 34
2. Distance and direction from nearest town or city: Street address of well location if in city:			3. Owner of well: R.R. or street: City, state, zip code:			
5. Type and color of material			From		To	
Clay			0		28	
Gyp			28		70	
Sdy clay			70		96	
Sd coarse T			96		103	
Fine sd clay T			103		126	
Fine sd clay			126		136	
Clay			136		147	
Fine sd clay			147		175	
Sd coarse			175		190	
Yellow			190		192	
(Use a second sheet if needed)						
18. Elevation:		19. Remarks:				
Topography: — Hill — Slope <input checked="" type="checkbox"/> Upland — Valley		20. Water well contractor's certification: This well was drilled under my jurisdiction and this report is true to the best of my knowledge and belief. Weishaar Drilling 232 Business name License No. Address: Scott City, KS 67871 Authorized representative: <i>[Signature]</i> Date: 4-21-76				

Forward the white, blue and pink copies to the Department of Health and Environment

Form WW-C-5

17 34 E 21 NWSESE
T R Sec 1/4 1/4 1/4

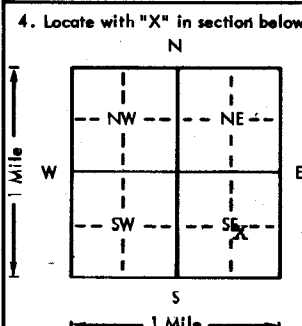

Sketch map:
Corral
↑ 1/2 mile N.
X well

4. Locate with "X" in section below:

6. Bore hole dia. 9 in. Completion date 3-17-76
Well depth 192 ft.

7. Cable tool Rotary Driven Dug
 Hollow rod Jetted Bored Reverse rotary

8. Use: Domestic Public supply Industry
 Irrigation Air conditioning Stock
 Lawn Oil field water Other

9. Casing: Material Plas. Height Above or below
Threaded Welded Glue Surface 12 in.
RMP PVC Weight 1.8 lbs./ft.
Dia. 5 in. to 172 ft. depth Wall Thickness: inches or
Dia. in. to ft. depth gage No. 250

10. Screen: Manufacturer's name Jess & Lowell
Type RMP Dia. 5 in.
Slot/gauze 1/16 Length 20 ft.
Set between 172 ft. and 192 ft.
ft. and ft.
Gravel pack? Size range of material 1-1/8 ft.

11. Static water level: 115 ft. below land surface Date 3-13-76 mo./day/yr.

12. Pumping level below land surfaces:
125 ft. after 1 hrs. pumping 18 g.p.m.
ft. after hrs. pumping g.p.m.
Estimated maximum yield 18 g.p.m.

13. Water sample submitted: mo./day/yr.
Yes No Date

14. Well head completion:
 Pitless adapter 12 inches above grade

15. Well grouted? yes
With: Neat cement Bentonite Concrete
Depth: From 0 ft. to 12 ft.

16. Nearest source of possible contamination:
ft. 2640 Direction N Type Corral
Well disinfected upon completion? Yes No

17. Pump: Not installed
Manufacturer's name Red Jacket
Model number 200T1 HP 2 Volts 220
Length of drop pipe 188 ft. capacity 18 g.p.m.
Type:
 Submersible Turbine
 Jet Reciprocating
 Centrifugal Other