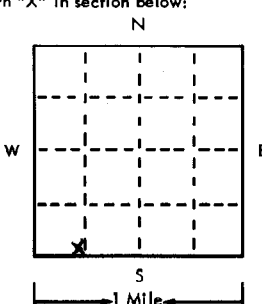
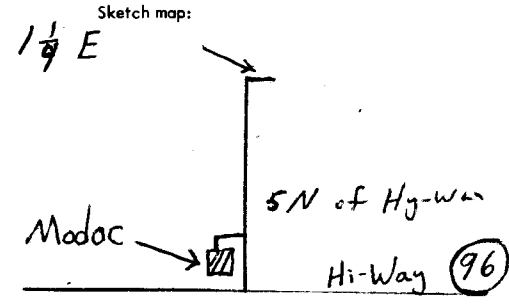


USE TYPEWRITER OR BALL POINT PEN-PRESS FIRMLY, PRINT CLEARLY.

T R EW sec 1/4 1/4 1/4 No.

WATER WELL RECORD
KSA 82a-1201-1215

Kansas State Dept. Of Health
(Water Well Contractors)
Forbes-Bldg. 740
Topeka, Kansas 66620

1 Location of well:	County Scott	Township name	Fraction SE 1/4 SW 1/4 SW 1/4	Section number 23	Town number 17	Range number 34
Distance and direction from nearest town or city: .25N .5E 4N				3 Owner of well: Harold Mast		
Street address of well location if in city: 1.25E of Modoc, KS				Address: Scott City, Kan 67871		
Locate with "X" in section below: 				Sketch map: 		
2				4 Well depth: 201 ft. Date of completion 4-30-77 Well diameter: 12 3/4 in.		
Type and color of material				5 <input type="checkbox"/> Cable tool <input checked="" type="checkbox"/> Rotary <input type="checkbox"/> Driven <input type="checkbox"/> Dug <input type="checkbox"/> Hollow rod <input type="checkbox"/> Jetted <input type="checkbox"/> Bored <input type="checkbox"/> Reverse rotary		
Soil				6 Use: <input type="checkbox"/> Domestic <input type="checkbox"/> Public supply <input type="checkbox"/> Industry <input checked="" type="checkbox"/> Irrigation <input type="checkbox"/> Air conditioning <input type="checkbox"/> Commercial <input type="checkbox"/> Test well <input type="checkbox"/>		
sand + Gyp				7 Casing: Material Steel Height: above /below Threaded <input type="checkbox"/> Welded <input checked="" type="checkbox"/> Surface 12 in. Diam. 12 in. to 201 ft. depth Drive shoe? <input type="checkbox"/> Yes <input checked="" type="checkbox"/> No 12 in. to 201 ft. depth		
clay				8 Screen: Manufacturer WA Brown Type Steel Dia. 12 3/4 Slot/gauze 10% Length 71 Set between 141 ft. and 210 ft. Fittings: 1/2" x 1" Gravel pack <input checked="" type="checkbox"/> Yes <input type="checkbox"/> No Size range of material 1/2" x 1"		
sand				9 Static water level: 120 ft. below land surface Date 4-30-77		
sandy clay				10 Pumping level below land surfaces: ____ ft. after ____ hrs. pumping ____ g.p.m. ____ ft. after ____ hrs. pumping ____ g.p.m. Estimated maximum yield 450 g.p.m.		
sandy + clay				11 Water sample submitted: <input type="checkbox"/> Yes <input checked="" type="checkbox"/> No Date ____		
clay				12 Well head completion: <input type="checkbox"/> Pitless adapter <input type="checkbox"/> Inches above grade		
Fair sand				13 Well grouted? <input checked="" type="checkbox"/> Yes <input type="checkbox"/> No <input checked="" type="checkbox"/> Neat cement <input type="checkbox"/> Bentonite <input type="checkbox"/> Depth: From 0 ft. to 10 ft.		
Yellow clay				14 Nearest source of possible contamination: ft. ____ Direction ____ Type ____ Well disinfected upon completion? <input type="checkbox"/> Yes <input type="checkbox"/> No		
Blue Shale				15 Pump: <input type="checkbox"/> Not installed Manufacturer's name Valley Model number ____ HP 50 Volts ____ Length of drop pipe 190 ft. capacity 450 g.p.m. Type: <input type="checkbox"/> Submersible <input checked="" type="checkbox"/> Turbine <input type="checkbox"/> Jet <input type="checkbox"/> Reciprocating <input type="checkbox"/> Centrifugal <input type="checkbox"/> Other		
(use a second sheet if needed)						
16 Remarks: elevation				17 Water well contractor's certification: This well was drilled under my jurisdiction and this report is true to the best of my knowledge and belief. WHINERY DRILLING 256 Business name 405 Antelope License No. Scott City, K Address 405 Antelope Signed J. E. ... Date 7-30-80 Authorized representative		

17 34W 23 SE SW SW

Forward the white, blue and pink copies to the Kansas State Dept. Of Health.

Form WWC-5