


1 LOCATION OF WATER WELL: County: **Scott** Fraction: **SE 1/4 NE 1/4 SE 1/4** Section Number: **35** Township Number: **T 17 S** Range Number: **R 34 E/W**

Distance and direction from nearest town or city street address of well if located within city?
7 West 3 1/2 North of Scott City

2 WATER WELL OWNER: **Do-Mar Farms**
 RR#, St. Address, Box #: **915 Crescent** Board of Agriculture, Division of Water Resources
 City, State, ZIP Code: **Scott City, Kansas** Application Number:

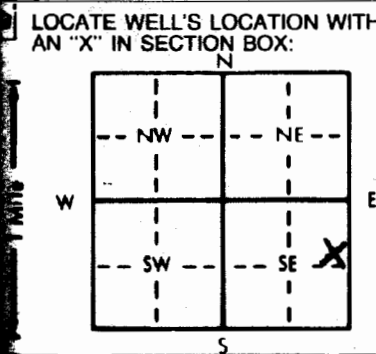

4 DEPTH OF COMPLETED WELL: **193** ft. ELEVATION:
 Depth(s) Groundwater Encountered 1. **135** ft. 2. ft. 3. ft.
 WELL'S STATIC WATER LEVEL **135** ft. below land surface measured on mo/day/yr
 Pump test data: Well water was **140** ft. after **2** hours pumping **15** gpm
 Est. Yield **50** gpm: Well water was ft. after hours pumping gpm
 Bore Hole Diameter **9** in. to **193** ft., and in. to ft.
 WELL WATER TO BE USED AS:
 1 Domestic 3 Feedlot 6 Oil field water supply 9 Dewatering 12 Other (Specify below)
 2 Irrigation 4 Industrial 7 Lawn and garden only 10 Monitoring well
 Was a chemical/bacteriological sample submitted to Department? Yes No **X**; If yes, mo/day/yr sample was submitted Water Well Disinfected? Yes **X** No

TYPE OF BLANK CASING USED:
 1 Steel 3 RMP (SR) 5 Wrought iron 8 Concrete tile CASING JOINTS: Glued **X** Clamped
 2 PVC 4 ABS 6 Asbestos-Cement 9 Other (specify below) Welded
 7 Fiberglass Threaded

Casing diameter **5** in. to **153** ft., Dia. in. to ft., Dia. in. to ft.
 Casing height above land surface **18** in., weight lbs./ft. Wall thickness or gauge No. **SDR21**

TYPE OF SCREEN OR PERFORATION MATERIAL:
 1 Steel 3 Stainless steel 5 Fiberglass 7 PVC 10 Asbestos-cement
 2 Brass 4 Galvanized steel 6 Concrete tile 8 RMP (SR) 11 Other (specify)
 12 None used (open hole)

SCREEN OR PERFORATION OPENINGS ARE:
 1 Continuous slot 3 Mill slot 5 Gauzed wrapped 8 Saw cut 11 None (open hole)
 2 Louvered shutter 4 Key punched 6 Wire wrapped 9 Drilled holes
 7 Torch cut 10 Other (specify)

SCREEN-PERFORATED INTERVALS: From **153** ft. to **193** ft., From ft. to ft.
 From ft. to ft., From ft. to ft.

GRAVEL PACK INTERVALS: From **20** ft. to **193** ft., From ft. to ft.
 From ft. to ft., From ft. to ft.

6 GROUT MATERIAL: 1 Neat cement 2 Cement grout 3 Bentonite 4 Other
 Grout Intervals: From **0** ft. to **20** ft., From ft. to ft., From ft. to ft.

What is the nearest source of possible contamination:
 1 Septic tank 4 Lateral lines 7 Pit privy 10 Livestock pens 14 Abandoned water well
 2 Sewer lines 5 Cess pool 8 Sewage lagoon 11 Fuel storage 15 Oil well/Gas well
 3 Watertight sewer lines 6 Seepage pit 9 Feedyard 12 Fertilizer storage 16 Other (specify below)
 13 Insecticide storage
 Direction from well? **South** How many feet? **100**

FROM	TO	LITHOLOGIC LOG	FROM	TO	PLUGGING INTERVALS
0	16	Topsoil & clay	173	177	Clay
16	33	Limestone & little clay	177	180	White rock (very, very hard)
33	45	Limestone	180	187	Yellow clay
45	49	Limestone & cemented sand (very hard)	187	193	Shale
49	65	Cemented sand & little limestone (hard)			
65	83	Cemented sand & little limestone			
83	87	Clay			
87	98	Cemented sand & little limestone			
98	114	Sandy clay			
114	132	Sandy clay & cemented sand			
132	147	Sand & limestone & little clay			
147	156	Fine sand			
156	159	Sandy clay			
159	164	Cemented sand			
164	173	Sand (medium)			

7 CONTRACTOR'S OR LANDOWNER'S CERTIFICATION: This water well was (1) constructed, (2) reconstructed, or (3) plugged under my jurisdiction and was completed on (mo/day/year) **9-2-92** and this record is true to the best of my knowledge and belief. Kansas Water Well Contractor's License No. **473**. This Water Well Record was completed on (mo/day/yr) **9-4-92** under the business name of **Tyler Water Well** by (signature) *Daryl Egan*

INSTRUCTIONS: Use typewriter or ball point pen. PLEASE PRESS FIRMLY and PRINT clearly. Please fill in blanks, underline or circle the correct answers. Send top three copies to Kansas Department of Health and Environment, Bureau of Water, Topeka, Kansas 66620-0001. Telephone: 913-296-5545. Send one to WATER WELL OWNER and retain one for your records.