


**WATER WELL PLUGGING RECORD Form WWC-5P**

KSA 82a-1212

ID NO.  

**1 LOCATION OF WATER WELL:**  
 County: WICHITA Fraction SW 1/4 14 1/4 1/4 Section Number 033 Township Number 17 ~~#3~~ Range Number 35 ~~38~~ ~~0W~~  
 Distance and direction from nearest town or city street address of well if located within city?  

**2 WATER WELL OWNER:** ZELLNER GARY  
 RR#, St. Address, Box #: RR #1 Box B  
 City, State ZIP Code: Marionethal, Ks 67863  
**Global Positioning Systems** (decimal degrees, min. of 4 digits)  
 Latitude: \_\_\_\_\_  
 Longitude: \_\_\_\_\_  
 Elevation: \_\_\_\_\_  
 Datum: \_\_\_\_\_  
 Data Collection Method: \_\_\_\_\_

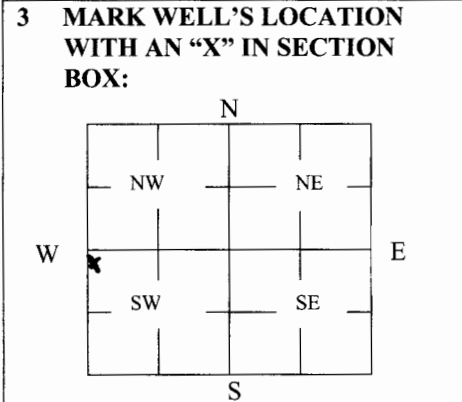

**4 DEPTH OF WELL** 196 ft.  
 WELL'S STATIC WATER LEVEL 0-0 ft.  
 WELL WAS USED AS:  
 1 Domestic                      5 Public Water Supply                      9 Dewatering  
 Irrigation                      6 Oil Field Water Supply                      10 Monitoring  
 3 Feedlot                      7 Domestic (Lawn & Garden)                      11 Injection Well  
 4 Industrial                      8 Air Conditioning                      12 Other \_\_\_\_\_  
 Was a chemical/bacteriological sample submitted to Department? Yes \_\_\_\_\_ No

**5 TYPE OF BLANK CASING USED:**  
 Steel      3 RMP (SR)      5 Wrought      7 Fiberglass      9 Other (Specify below) \_\_\_\_\_  
 2 PVC      4 ABS      6 Asbestos-Cement      8 Concrete Tile \_\_\_\_\_  
 Blank casing diameter 16 in. Was casing pulled? Yes  No \_\_\_\_\_ If yes, how much 48"  
 Casing height above or below land surface 48 in.

**6 GROUT PLUG MATERIAL:**      1 Neat cement      2 Cement grout       Bentonite      4 Other \_\_\_\_\_  
 Grout Plug Intervals: From 196 ft. to 50 ft., From 50 ft. to 7 ft., From 7 to 4 ft.  
 What is the nearest source of possible contamination:  
 Septic tank      6 Seepage pit      11 Fuel Storage      16 Other (specify below) \_\_\_\_\_  
 2 Sewer lines      7 Pit privy      12 Fertilizer storage      \_\_\_\_\_  
 3 Watertight sewer lines      8 Sewage lagoon      13 Insecticide storage      \_\_\_\_\_  
 4 Lateral lines      9 Feedyard      14 Abandoned water well      Direction from well? S  
 5 Cess pool      10 Livestock pens      15 Oil well/Gas well      How many feet? 1650

FROM	TO	PLUGGING MATERIALS	FROM	TO	PLUGGING MATERIALS
196	50	Sand			
50	7	Clay			
7	4	Bentonite			
4	0	Clay			

**7 CONTRACTOR'S OR LANDOWNER'S CERTIFICATION:** This water well was plugged under my jurisdiction and was completed on (mo/day/year) 11-24-08 and this record is true to the best of my knowledge and belief. Kansas Water Well Contractor's License No. \_\_\_\_\_ This Water Well Record was completed on (mo/day/year) 11-24-08 under the business name of Jones Construction by (signature) Neil Andersen

**INSTRUCTIONS:** Use typewriter or ballpoint pen. Please press firmly and print clearly. Please fill in blanks, underline or circle the correct answers. Send top three copies to Kansas Department of Health and Environment, Bureau of Water, Geology Section, 1000 SW Jackson St., Ste. 420, Topeka, Kansas 66612-1367. Telephone: 785/296-5522. Send one to Water Well Owner and retain one for your records. Visit us at <http://www.kdheks.gov/geo/waterwells>.