


WATER WELL RECORD Form WWC-5 KSA 82a-1212

1 LOCATION OF WATER WELL: Fraction SW 1/4 SW 1/4 SW 1/4 Section Number 36 Township Number T 17 S Range Number R 35 E
 County: Wichita

Distance and direction from nearest town or city street address of well if located within city?
4M SE of Maranthal Ks

2 WATER WELL OWNER: Earl Smith
 RR#, St. Address, Box # :
 City, State, ZIP Code : Wichita, Ks
 Board of Agriculture, Division of Water Resources
 Application Number:

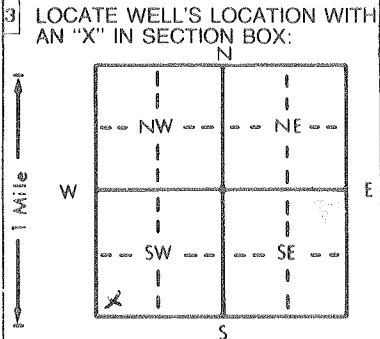

4 DEPTH OF COMPLETED WELL: 180 ft. ELEVATION:
 Depth(s) Groundwater Encountered 1. 140 ft. 2. _____ ft. 3. _____ ft.
 WELL'S STATIC WATER LEVEL 140 ft. below land surface measured on mo/day/yr
 Pump test data: Well water was _____ ft. after _____ hours pumping _____ gpm
 Est. Yield 20 gpm: Well water was _____ ft. after _____ hours pumping _____ gpm
 Bore Hole Diameter 9.0 in. to 180 ft., and _____ in. to _____ ft.
 WELL WATER TO BE USED AS:
 Domestic 3 Feedlot 6 Oil field water supply 9 Dewatering 12 Other (Specify below)
 2 Irrigation 4 Industrial 7 Lawn and garden only 10 Monitoring well _____
 Was a chemical/bacteriological sample submitted to Department? Yes _____ No X; If yes, mo/day/yr sample was submitted
 Water Well Disinfected? Yes X No

5 TYPE OF BLANK CASING USED:
 1 Steel 3 RMP (SR) 5 Wrought iron 8 Concrete tile CASING JOINTS: Glued X Clamped _____
 PVC 4 ABS 6 Asbestos-Cement 9 Other (specify below) Welded _____
 Blank casing diameter 0 in. to 140 ft., Dia _____ in. to _____ ft., Dia _____ in. to _____ ft.
 Casing height above land surface 12 in., weight 950 lbs./ft. Wall thickness or gauge No. 250
 TYPE OF SCREEN OR PERFORATION MATERIAL:
 1 Steel 3 Stainless steel 5 Fiberglass PVC 10 Asbestos-cement
 2 Brass 4 Galvanized steel 6 Concrete tile 8 RMP (SR) 11 Other (specify) _____
 9 ABS 12 None used (open hole)
 SCREEN OR PERFORATION OPENINGS ARE:
 Continuous slot 3 Mill slot 5 Gauzed wrapped 8 Saw cut 11 None (open hole)
 2 Louvered shutter 4 Key punched 6 Wire wrapped 9 Drilled holes
 7 Torch cut 10 Other (specify) _____
 SCREEN-PERFORATED INTERVALS: From 140 ft. to 180 ft., From _____ ft. to _____ ft.
 From _____ ft. to _____ ft., From _____ ft. to _____ ft.
 GRAVEL PACK INTERVALS: From 140 ft. to 180 ft., From _____ ft. to _____ ft.
 From _____ ft. to _____ ft., From _____ ft. to _____ ft.

6 GROUT MATERIAL: 1 Neat cement 2 Cement grout Bentonite 4 Other _____
 Grout Intervals: From 0 ft. to 20 ft., From _____ ft. to _____ ft., From _____ ft. to _____ ft.
 What is the nearest source of possible contamination:
 Septic tank 4 Lateral lines 7 Pit privy 10 Livestock pens 14 Abandoned water well
 Sewer lines 5 Cess pool 8 Sewage lagoon 11 Fuel storage 15 Oil well/Gas well
 3 Watertight sewer lines 6 Seepage pit 9 Feedyard 12 Fertilizer storage 16 Other (specify below)
 13 Insecticide storage _____
 Direction from well? West How many feet? 300

FROM	TO	LITHOLOGIC LOG	FROM	TO	PLUGGING INTERVALS
0	30	Top soil			
30	100	S clay Fine Sand			
100	140	slay			
140	152	1M gravel Fine Sand			
152	178	Sandy clay Fine Sand			
178	180	Shale			

7 CONTRACTOR'S OR LANDOWNER'S CERTIFICATION: This water well was constructed, reconstructed, or plugged under my jurisdiction and was completed on (mo/day/year) 6-2-14 and this record is true to the best of my knowledge and belief. Kansas Water Well Contractor's License No. 376 This Water Well Record was completed on (mo/day/yr) 8-14 under the business name of B+B Pilly LLC by (signature) Joseph Beckman

INSTRUCTIONS: Use typewriter or ball point pen. PLEASE PRESS FIRMLY and PRINT clearly. Please fill in blanks, underline or circle the correct answers. Send top three copies to Kansas Department of Health and Environment, Bureau of Water, Topeka, Kansas 66620-0001. Telephone: 913-296-5545. Send one to WATER WELL OWNER and retain one for your records.