

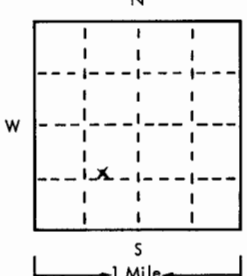
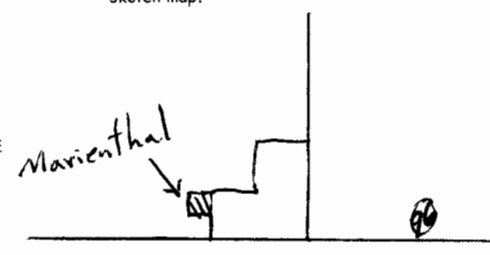
USE TYPEWRITER OR BALL POINT PEN-PRESS FIRMLY, PRINT CLEARLY.

T R EW sec 1/4 1/4 1/4 No.

WATER WELL RECORD
KSA 82a-1201-1215

Kansas State Dept. Of Health
(Water Well Contractors)
Forbes-Bldg. 740
Topeka, Kansas 66620

SW 1/4 NE 1/4 SW 1/4

1 Location of well:	County Wichita	Township name Edwards	Fraction SW 1/4	Section number 34	Town number 17	Range number 35
Distance and direction from nearest town or city: .5E .5N 1E 2N			3 Owner of well: Veronica Berning			
Street address of well location if in city: of Marienthal			Address: Marienthal, Kansas			
Locate with "X" in section below: N  W E S 1 Mile			Sketch map: 			4 Well depth: 202 ft. Date of completion 2-23-76 Well diameter 12 in.
2 Type and color of material			From		To	
			soil		0 10	
clay		10 48		5 <input type="checkbox"/> Cable tool <input checked="" type="checkbox"/> Rotary <input type="checkbox"/> Driven <input type="checkbox"/> Dug <input type="checkbox"/> Hollow rod <input type="checkbox"/> Jetted <input type="checkbox"/> Bored <input type="checkbox"/> Reverse rotary		
Rock gyp		48 55		6 Use: <input type="checkbox"/> Domestic <input type="checkbox"/> Public supply <input type="checkbox"/> Industry <input checked="" type="checkbox"/> Irrigation <input type="checkbox"/> Air conditioning <input type="checkbox"/> Commercial <input type="checkbox"/> Test well <input type="checkbox"/>		
sand		55 70		7 Casing: Material Steel Height: (above/below) (above) Threaded <input type="checkbox"/> Welded <input checked="" type="checkbox"/> Surface 12 in. Diam. 12 in. to 14 1/2 in. depth Drive shoe? <input type="checkbox"/> Yes <input checked="" type="checkbox"/> No 12 in. to 14 1/2 in. depth		
clay		70 100		8 Screen: Manufacturer W.A. Brown Type Steel Dia. 12" Slot/gauze _____ Length 260 Set between 142 ft. and 202 ft. Fittings: Gravel pack <input checked="" type="checkbox"/> Yes <input type="checkbox"/> No Size range 1/2" 1"		
sand		100 103		9 Static water level: 140 ft. below land surface Date 2-23-76		
clay		103 105		10 Pumping level below land surfaces: ____ ft. after ____ hrs. pumping ____ g.p.m. ____ ft. after ____ hrs. pumping ____ g.p.m. Estimated maximum yield 500 g.p.m.		
sand clay		105 107		11 Water sample submitted: <input type="checkbox"/> Yes <input checked="" type="checkbox"/> No Date _____		
sand clay		107 117		12 Well head completion: <input type="checkbox"/> Pitless adapter <input type="checkbox"/> Inches above grade		
sand sand		117 135		13 Well grouted? <input checked="" type="checkbox"/> Yes <input type="checkbox"/> No <input checked="" type="checkbox"/> Neat cement <input type="checkbox"/> Bentonite <input type="checkbox"/> _____ Depth: From 0 ft. to 10 ft.		
clay sand		135 137		14 Nearest source of possible contamination: ft. _____ Direction _____ Type _____ Well disinfected upon completion? <input type="checkbox"/> Yes <input type="checkbox"/> No		
clay sand		137 138		15 Pump: <input checked="" type="checkbox"/> Not installed Manufacturer's name _____ Model number _____ HP _____ Volts _____ Length of drop pipe _____ ft. capacity _____ g.m.p. Type: <input type="checkbox"/> Submersible <input type="checkbox"/> Turbine <input type="checkbox"/> Jet <input type="checkbox"/> Reciprocating <input type="checkbox"/> Centrifugal <input type="checkbox"/> Other		
sandy clay sand		138 141		16 Remarks: elevation Topography: <input type="checkbox"/> Hill <input type="checkbox"/> Slope <input type="checkbox"/> Upland <input type="checkbox"/> Valley		
clay sand streaks of clay		141 145				
clay sand		145 150		17 Water well contractor's certification: This well was drilled under my jurisdiction and this report is true to the best of my knowledge and belief. WHINSKY DRILLING 256 Business name _____ License No. _____ Address 405 Antelope Scott City, Mo. Signed John Whinsky Date 7-22-86 Authorized representative		
clay sand		150 159				
clay yellow clay		159 165				
Blue shale		165 171				
(use a second sheet if needed)		171 175				
		175 180				
		180 192				
		192 202				

17 35-034 SW NE 1/4 SW