


1 LOCATION OF WATER WELL:	Fraction	Section Number	Township Number	Range Number
County: Wichita	NW ¼ NW ¼ NW ¼	24	T 17 S	R 36 EW

Distance and direction from nearest town or city street address of well if located within city?

2 WATER WELL OWNER: **Jason Berning**
 RR#, St. Address, Box #: **500 N Wichita-Scott Rd**
 City, State, ZIP Code: **Marienthal, KS 67863**
 Board of Agriculture, Division of Water Resources
 Application Number: **1275**

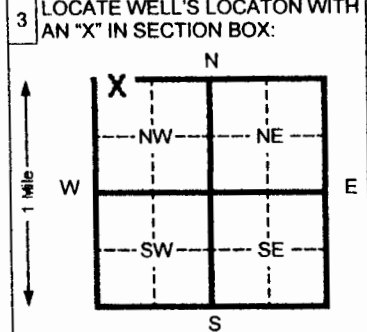

4 DEPTH OF COMPLETED WELL **213** ft. ELEVATION: _____

Depth(s) Groundwater Encountered 1 _____ ft. 2 _____ ft. 3 _____ ft.

WELL'S STATIC WATER LEVEL **NA** ft. below land surface measured on mo/day/yr

Pump test data: Well water was _____ ft. after _____ hours pumping _____ gpm

Est. Yield _____ gpm: Well water was _____ ft. after _____ hours pumping _____ gpm

Bore Hole Diameter **28** in. to **200** ft. and _____ in. to _____ ft.

WELL WATER TO BE USED AS: 5 Public water supply 8 Air conditioning 11 Injection well
 1 Domestic 3 Feed lot 6 Oil field water supply 9 Dewatering 12 Other (Specify below)
 2 Irrigation 4 Industrial 7 Lawn and garden (domestic) 10 Monitoring well

Was a chemical/bacteriological sample submitted to Department? Yes _____ No X If yes, mo/day/yr sample was submitted _____

Water Well Disinfected? Yes _____ No X

5 TYPE OF BLANK CASING USED:

1 Steel	3 RMP (SR)	5 Wrought Iron	8 Concrete tile	CASING JOINTS: Glued <input checked="" type="checkbox"/> X Clamped _____
<input checked="" type="radio"/> 2 PVC	4 ABS	6 Asbestos-Cement	9 Other (specify below) _____	Welded _____
		7 Fiberglass		Threaded _____

Blank casing diameter **16** in. to **173** ft., Dia _____ in. to _____ ft., Dia _____ in. to _____ ft.

Casing height above land surface **24** in., weight **16.15** lbs./ft. Wall thickness or gauge No. **.500**

TYPE OF SCREEN OR PERFORATION MATERIAL:

1 Steel	3 Stainless steel	5 Fiberglass	8 RMP (SR)	10 Asbestos-cement
2 Brass	4 Galvanized steel	6 Concrete tile	9 ABS	11 Other (specify) _____

SCREEN OR PERFORATION OPENINGS ARE:

1 Continuous slot	3 Mill slot	5 Gauzed wrapped	<input checked="" type="radio"/> 8 Saw cut	11 None (open hole)
2 Louvered shutter	4 Key punched	6 Wire wrapped	9 Drilled holes	
		7 Torch cut	10 Other (specify) _____	

SCREEN-PERFORATED INTERVALS: From **173** ft. to **213** ft. From _____ ft. to _____ ft.

GRAVEL PACK INTERVALS: From **20** ft. to **213** ft. From _____ ft. to _____ ft.

6 GROUT MATERIAL: 1 Neat cement 2 Cement grout 3 Bentonite 4 Other _____

Grout Intervals From **0** ft. to **20** ft. From _____ ft. to _____ ft. From _____ ft. to _____ ft.

What is the nearest source of possible contamination:

1 Septic tank	4 Lateral lines	7 Pit privy	10 Livestock pens	14 Abandoned water well
2 Sewer lines	5 Cess pool	8 Sewage lagoon	11 Fuel storage	15 Oil well/ Gas well
3 Watertight sewer lines	6 Seepage pit	9 Feedyard	12 Fertilizer storage	16 Other (specify below)
			13 Insecticide storage	None

Direction from well? _____ How many feet? _____

FROM	TO	CODE	LITHOLOGIC LOG	FROM	TO	PLUGGING INTERVALS
0	2		Surface			Clay Strks
2	20		Loess	185	203	Fine to Medium Sand with Lots of Gravel
20	63		Clay & Caliche			Yellow Ochre
63	80		Fine to Medium Sand w/ Caliche Strks	203	213	
80	90		Clay & Caliche			
90	115		Fine to Medium Sand with Clay Strks			
115	117		Cemented Sand			
117	135		Fine to Medium Sand with Clay Strks			
135	143		Fine to Medium Sand with Clay & Caliche Strks			
143	185		Fine to Medium Sand with			

7 CONTRACTOR'S OR LANDOWNER'S CERTIFICATION: This water well was (1) constructed, (2) reconstructed, or (3) plugged under my jurisdiction and was completed on (mo/day/yr) **4-11-06** and this record is true to the best of my knowledge and belief. Kansas Water Well Contractor's License No. **554** This Water Well Record was completed on (mo/day/yr) **4-21-06** under the business name of **Woofert Pump & Well Inc.** by (signature) _____

INSTRUCTIONS: Please fill in blanks and circle the correct answers. Send three copies to Kansas Department of Health and Environment, Bureau of Water, 1000 S W Jackson St., Ste. 420, Topeka, Kansas 66612-1367. Telephone: 913-296-5545. Send one to WATER WELL OWNER and retain one for your records.