

McKenney

WATER WELL PLUGGING RECORD Form WWC-5P KSA 82a-1212 ID NO.


1 LOCATION OF WATER WELL: County: WICHITA Fraction NW 1/4 1/4 Section Number 34 Township Number 17S Range Number 36 BW

Distance and direction from nearest town or city street address of well if located within city?

2 WATER WELL OWNER: Mac Farm c/o Kurt McKinney RR#, St. Address, Box #: PO Box 101 City, State ZIP Code: Leoti, Ks 67561

Global Positioning Systems (decimal degrees, min. of 4 digits) Latitude: Longitude: Elevation: Datum: Data Collection Method:

3 MARK WELL'S LOCATION WITH AN "X" IN SECTION BOX:

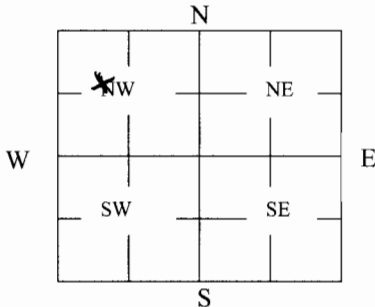

4 DEPTH OF WELL 194 ft.

WELL'S STATIC WATER LEVEL 0.0 ft

WELL WAS USED AS:

- 1 Domestic, 2 Irrigation, 3 Feedlot, 4 Industrial, 5 Public Water Supply, 6 Oil Field Water Supply, 7 Domestic (Lawn & Garden), 8 Air Conditioning, 9 Dewatering, 10 Monitoring, 11 Injection Well, 12 Other

Was a chemical/bacteriological sample submitted to Department? Yes No X

5 TYPE OF BLANK CASING USED:

- 1 Steel, 2 PVC, 3 RMP (SR), 4 ABS, 5 Wrought, 6 Asbestos-Cement, 7 Fiberglass, 8 Concrete Tile, 9 Other (Specify below)

Blank casing diameter 16 in. Was casing pulled? Yes X No If yes, how much 48" Casing height above or below land surface 48" in.

6 GROUT PLUG MATERIAL: 1 Neat cement, 2 Cement grout, 3 Bentonite, 4 Other

Grout Plug Intervals: From 194 ft. to 42 ft., From 42 ft. to 7 ft., From 7 to 4 ft.

What is the nearest source of possible contamination:

- 1 Septic tank, 2 Sewer lines, 3 Watertight sewer lines, 4 Lateral lines, 5 Cess pool, 6 Seepage pit, 7 Pit privy, 8 Sewage lagoon, 9 Feedyard, 10 Livestock pens, 11 Fuel Storage, 12 Fertilizer storage, 13 Insecticide storage, 14 Abandoned water well, 15 Oil well/Gas well, 16 Other (specify below) NONE

Table with 6 columns: FROM, TO, PLUGGING MATERIALS, FROM, TO, PLUGGING MATERIALS. Rows contain data for grout plug intervals: 194 to 42 (Sand), 42 to 7 (Dirt), 7 to 4 (Bentonite), 4 to 0 (Dirt).

7 CONTRACTOR'S OR LANDOWNER'S CERTIFICATION: This water well was plugged under my jurisdiction and was completed on (mo/day/year) 1-15-09 and this record is true to the best of my knowledge and belief. Kansas Water Well Contractor's License No. This Water Well Record was completed on (mo/day/year) 1-15-09 under the business name of Jones Contractors by (signature) Cliff Carter

INSTRUCTIONS: Use typewriter or ballpoint pen. Please press firmly and print clearly. Please fill in blanks, underline or circle the correct answers. Send top three copies to Kansas Department of Health and Environment, Bureau of Water, Geology Section, 1000 SW Jackson St., Ste. 420, Topeka, Kansas 66612-1367. Telephone: 785/296-5522. Send one to Water Well Owner and retain one for your records. Visit us at http://www.kdheks.gov/geo/waterwells.