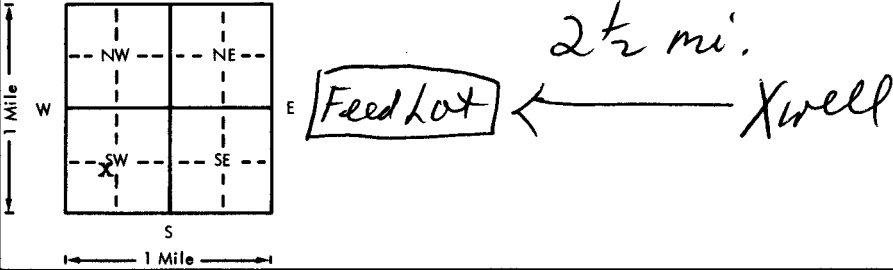


USE TYPEWRITER OR BALL POINT PEN-PRESS FIRMLY, PRINT CLEARLY.

WATER WELL RECORD  
KSA 82a-1201-1215

Kansas Department of Health and Environment-Division of Environment  
(Water well Contractors)  
Topeka, Kansas 66620

1. Location of well:		County <b>Wichita</b>	Fraction <b>NE 1/4 SW 1/4 SW 1/4</b>	Section number <b>8</b>	Township number <b>T 17 S R 36 E 12</b>	Range number <b>36 E 12</b>	
2. Distance and direction from nearest town or city: <b>2E, 8N, 1W,</b> Street address of well location if in city: <b>3/4S, 1/4E of Leoti, KS</b>			3. Owner of well: <b>Frank Whitham</b> R.R. or street: <b>Box # Q</b> City, state, zip code: <b>Leoti, KS 67861</b>				
4. Locate with "X" in section below: N W E S 1 Mile 1 Mile		Sketch map: 		6. Bore hole dia. <u>26</u> in. Completion date <u>5-24-76</u> Well depth <u>180</u> ft.			
5. Type and color of material		From	To	7. <input type="checkbox"/> Cable tool <input type="checkbox"/> Rotary <input type="checkbox"/> Driven <input type="checkbox"/> Dug <input type="checkbox"/> Hollow rod <input type="checkbox"/> Jetted <input checked="" type="checkbox"/> Bored <input checked="" type="checkbox"/> Reverse rotary			
Clay		0	20	8. Use: <input type="checkbox"/> Domestic <input type="checkbox"/> Public supply <input type="checkbox"/> Industry <input checked="" type="checkbox"/> Irrigation <input type="checkbox"/> Air conditioning <input type="checkbox"/> Stock <input type="checkbox"/> Lawn <input type="checkbox"/> Oil field water <input type="checkbox"/> Other			
Gyp		20	39	9. Casing: Material <u>Steel</u> Height: <u>Above</u> or below Threaded <input type="checkbox"/> Welded <input checked="" type="checkbox"/> Surface <u>10</u> in. RMP <input type="checkbox"/> PVC <input type="checkbox"/> Weight <u>31.67</u> lbs./ft. Dia. <u>16</u> in. to <u>180</u> ft. depth; Wall Thickness: inches or Dia. <u>   </u> in. to <u>   </u> ft. depth; gage No. <u>188</u>			
Clay		39	49	10. Screen: Manufacturer's name <u>Free Flow</u> Type <u>Prime Steel</u> Dia. <u>16 in.</u> <input checked="" type="checkbox"/> Gauze <u>.125</u> Length <u>40 ft.</u> Set between <u>140</u> ft. and <u>180</u> ft. <u>   </u> ft. and <u>   </u> ft.			
Sdy clay T		49	60	Gravel pack? <u>yes</u> Size range of material <u>5-24/4</u>			
Sd coarse		60	80	11. Static water level: <u>120</u> ft. below land surface Date <u>5-24-76</u> mo./day/yr.			
Fine sd clay		80	117	12. Pumping level below land surfaces: <u>150</u> ft. after <u>8</u> hrs. pumping <u>300</u> g.p.m. <u>   </u> ft. after <u>   </u> hrs. pumping <u>   </u> g.p.m. Estimated maximum yield <u>300</u> g.p.m.			
Sd med		117	125	13. Water sample submitted: <u>   </u> mo./day/yr. Yes <input checked="" type="checkbox"/> No <input type="checkbox"/> Date <u>   </u>			
Fine sd		125	150	14. Well head completion: <input type="checkbox"/> Pitless adapter <u>12</u> inches above grade			
Fine sd clay		150	162	15. Well grouted? <input checked="" type="checkbox"/> With: <input type="checkbox"/> Neat cement <input type="checkbox"/> Bentonite <input checked="" type="checkbox"/> Concrete Depth: From <u>0</u> ft. to <u>15</u> ft.			
Sd coarse		162	168	16. Nearest source of possible contamination: <u>Feed</u> ft. <u>1200</u> Direction <u>W</u> Type <u>Lot</u>			
Fine sd clay		168	175	Well disinfected upon completion? <input checked="" type="checkbox"/> Yes <input type="checkbox"/> No			
Clay yellow		175	188	17. Pump: <input checked="" type="checkbox"/> Not installed Manufacturer's name <u>   </u> Model number <u>   </u> HP <u>   </u> Volts <u>   </u> Length of drop pipe <u>   </u> ft. capacity <u>   </u> g.p.m. Type: <input type="checkbox"/> Submersible <input type="checkbox"/> Turbine <input type="checkbox"/> Jet <input type="checkbox"/> Reciprocating <input type="checkbox"/> Centrifugal <input type="checkbox"/> Other			
Shale		188	190	20. Water well contractor's certification: This well was drilled under my jurisdiction and this report is true to the best of my knowledge and belief. <u>Weishaar Drilling</u> <u>232</u> Business name <u>   </u> license No. <u>   </u> Address <u>Scott City, KS 67871</u> Signature <u>   </u> Date <u>7-21-76</u> Authorized representative <u>   </u>			
18. Elevation:		19. Remarks:		20. Water well contractor's certification:			
Topography: <input type="checkbox"/> Hill <input checked="" type="checkbox"/> Slope <input type="checkbox"/> Upland <input type="checkbox"/> Valley							

Forward the white, blue and pink copies to the Department of Health and Environment

Form WWC-5