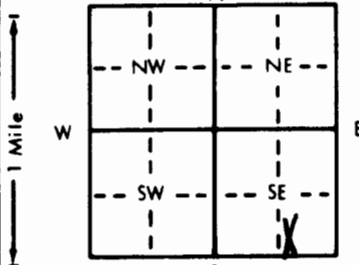


1 LOCATION OF WATER WELL: Fraction SW 1/4 SE 1/4 SE 1/4 Section Number 29 Township Number T 17 S Range Number R 37 EW
 County: Wichita
 Distance and direction from nearest town or city street address of well if located within city?

2 WATER WELL OWNER: Gary Wilbur
 RR#, St. Address, Box #: Leoti, Ks. 67861 Board of Agriculture, Division of Water Resources
 City, State, ZIP Code: Application Number: 11396

3 LOCATE WELL'S LOCATION WITH AN "X" IN SECTION BOX:  4 DEPTH OF COMPLETED WELL: 193 ft. ELEVATION:
 Depth(s) Groundwater Encountered 1. ft. 2. ft. 3. ft.
 WELL'S STATIC WATER LEVEL: 153 ft. below land surface measured on mo/day/yr
 Pump test data: Well water was ft. after hours pumping gpm
 Est. Yield gpm: Well water was ft. after hours pumping gpm
 Bore Hole Diameter: 24 in. to 193 ft. and in. to ft.
 WELL WATER TO BE USED AS: 5 Public water supply 8 Air conditioning 11 Injection well
 1 Domestic 3 Feedlot 6 Oil field water supply 9 Dewatering 12 Other (Specify below)
 2 Irrigation 4 Industrial 7 Lawn and garden only 10 Monitoring well
 Was a chemical/bacteriological sample submitted to Department? Yes No X; If yes, mo/day/yr sample was submitted Water Well Disinfected? Yes No X

5 TYPE OF BLANK CASING USED: 5 Wrought iron 8 Concrete tile CASING JOINTS: Glued X Clamped
 1 Steel 3 RMP (SR) 6 Asbestos-Cement 9 Other (specify below) Welded
 2 PVC 4 ABS 7 Fiberglass Threaded
 Blank casing diameter: 16 in. to 133 ft. Dia. in. to ft. Dia. in. to ft.
 Casing height above land surface: 24 in., weight: 16.15 lbs./ft. Wall thickness or gauge No. 500
 TYPE OF SCREEN OR PERFORATION MATERIAL: 7 PVC 10 Asbestos-cement
 1 Steel 3 Stainless steel 5 Fiberglass 8 RMP (SR) 11 Other (specify)
 2 Brass 4 Galvanized steel 6 Concrete tile 9 ABS 12 None used (open hole)
 SCREEN OR PERFORATION OPENINGS ARE: 5 Gauzed wrapped 8 Saw cut 11 None (open hole)
 1 Continuous slot 3 Mill slot 6 Wire wrapped 9 Drilled holes
 2 Louvered shutter 4 Key punched 7 Torch cut 10 Other (specify)
 SCREEN-PERFORATED INTERVALS: From 133 ft. to 193 ft. From ft. to ft.
 GRAVEL PACK INTERVALS: From 20 ft. to 193 ft. From ft. to ft.

6 GROUT MATERIAL: 1 Neat cement 2 Cement grout 3 Bentonite 4 Other
 Grout Intervals: From 0 ft. to 20 ft. From ft. to ft. From ft. to ft.
 What is the nearest source of possible contamination: NONE 10 Livestock pens 14 Abandoned water well
 1 Septic tank 4 Lateral lines 7 Pit privy 11 Fuel storage 15 Oil well/Gas well
 2 Sewer lines 5 Cess pool 8 Sewage lagoon 12 Fertilizer storage 16 Other (specify below)
 3 Watertight sewer lines 6 Seepage pit 9 Feedyard 13 Insecticide storage

Direction from well? How many feet?

| FROM | TO | LITHOLOGIC LOG | FROM | TO | PLUGGING INTERVALS |
|------|-------|----------------------------------|-------|-----|------------------------------|
| 0 | 2 | Surface | 144.5 | 153 | Semi-Tight Fine to Med. Sand |
| 2 | 20 | Loess | | | W/Clay |
| 20 | 22 | Clay & Caliche | 153 | 166 | Fine to Med. Sand w/a Few |
| 22 | 34 | Caliche & Clay | | | Clay Layers |
| 34 | 46 | Caliche w/Hard Strks. | 166 | 182 | Med. Sand & Gravel |
| 46 | 52 | Caliche w/Clay | 182 | 183 | Ochre |
| 52 | 60 | Fine to Med. Sand w/Clay | | 193 | Shale |
| 60 | 105 | Sandy Clay w/Caliche w/Some Sand | | | |
| 105 | 107 | Caliche | | | |
| 107 | 115 | Sandy Clay w/Sand Strks. | | | |
| 115 | 130 | Med. Sand w/Clay | | | |
| 130 | 134 | Sandy Clay w/Sand Strks. | | | |
| 134 | 135 | Cemented Sand | | | |
| 135 | 140 | Sandy Clay w/Sand Strks. | | | |
| 140 | 144.5 | Cemented Sand | | | |

7 CONTRACTOR'S OR LANDOWNER'S CERTIFICATION: This water well was (1) constructed, (2) reconstructed, or (3) plugged under my jurisdiction and was completed on (mo/day/year) 1-7-97 and this record is true to the best of my knowledge and belief. Kansas Water Well Contractor's License, No. 554 This Water Well Record was completed on (mo/day/yr) 1-22-97 under the business name of WDOFTER PUMP & WELL, INC. by (signature) Gary Wilbur