


1 LOCATION OF WATER WELL: Fraction NW 1/4 SE 1/4 NW 1/4 Section Number 26 Township Number T 17 S Range Number R 37 EW
 County: Wichita

Distance and direction from nearest town or city street address of well if located within city?
 4 1/2 miles North 1/2 mile West of Leoti

2 WATER WELL OWNER: Whit-Crop Partnership
 RR#, St. Address, Box #: R.R. 2 Box 200 Board of Agriculture, Division of Water Resources
 City, State, ZIP Code: Leoti, Ks 67871 Application Number: 7363

3 LOCATE WELL'S LOCATION WITH AN "X" IN SECTION BOX: 4 DEPTH OF COMPLETED WELL: 192 ft. ELEVATION: 3325

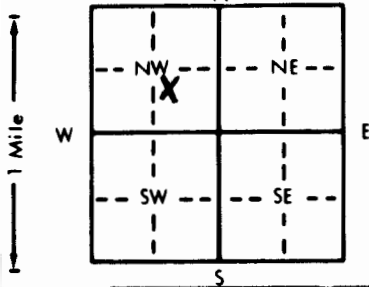

Depth(s) Groundwater Encountered 1 139 ft. 2. ft. 3. ft.
 WELL'S STATIC WATER LEVEL 139 ft. below land surface measured on mo/day/yr 9-30-93
 Pump test data: Well water was 190 ft. after hours pumping 200 gpm
 Est. Yield 200 gpm: Well water was ft. after hours pumping gpm
 Bore Hole Diameter 26 in. to 192 ft. and in. to ft.
 WELL WATER TO BE USED AS: 5 Public water supply 8 Air conditioning 11 Injection well
 1 Domestic 3 Feedlot 6 Oil field water supply 9 Dewatering 12 Other (Specify below)
 2 Irrigation 4 Industrial 7 Lawn and garden only 10 Monitoring well
 Was a chemical/bacteriological sample submitted to Department? Yes No X; If yes, mo/day/yr sample was submitted
 Water Well Disinfected? Yes X No

5 TYPE OF BLANK CASING USED: 5 Wrought iron 8 Concrete tile CASING JOINTS: Glued X Clamped
 1 Steel 3 RMP (SR) 6 Asbestos-Cement 9 Other (specify below) Welded
 2 PVC 4 ABS 7 Fiberglass Threaded

Blank casing diameter 12 in. to 152 ft., Dia in. to ft., Dia in. to ft.
 Casing height above land surface 12 in., weight lbs./ft. Wall thickness or gauge No. SDR26

TYPE OF SCREEN OR PERFORATION MATERIAL: 7 PVC 10 Asbestos-cement
 1 Steel 3 Stainless steel 5 Fiberglass 8 RMP (SR) 11 Other (specify)
 2 Brass 4 Galvanized steel 6 Concrete tile 9 ABS 12 None used (open hole)

SCREEN OR PERFORATION OPENINGS ARE: 5 Gauzed wrapped 8 Saw cut 11 None (open hole)
 1 Continuous slot 3 Mill slot 6 Wire wrapped 9 Drilled holes
 2 Louvered shutter 4 Key punched 7 Torch cut 10 Other (specify)

SCREEN-PERFORATED INTERVALS: From 152 ft. to 192 ft., From ft. to ft.
 GRAVEL PACK INTERVALS: From 20 ft. to 192 ft., From ft. to ft.

6 GROUT MATERIAL: 1 Neat cement 2 Cement grout 3 Bentonite 4 Other
 Grout Intervals: From 0 ft. to 20 ft., From ft. to ft., From ft. to ft.

What is the nearest source of possible contamination:
 1 Septic tank 4 Lateral lines 7 Pit privy 10 Livestock pens 14 Abandoned water well
 2 Sewer lines 5 Cess pool 8 Sewage lagoon 11 Fuel storage 15 Oil well/Gas well
 3 Watertight sewer lines 6 Seepage pit 9 Feedyard 12 Fertilizer storage 16 Other (specify below)
 13 Insecticide storage

Direction from well? west How many feet? 290

FROM	TO	LITHOLOGIC LOG	FROM	TO	PLUGGING INTERVALS
0	16	top soil & cliche	170	172	clay
16	32	clay & cliche	172	180	sand (medium to coarse) loose
32	49	cliche & little clay	180	184	yellow shale
49	60	sandy clay & little cliche	184	192	blue shale
60	65	sand			
65	82	sand & gravel			
82	90	sandy clay			
90	98	sand & 2ft. clay			
98	114	sandy clay & little cliche			
114	128	sandy clay			
128	132	sand & gravel (tight)			
132	147	sand & gravel			
147	153	sand (medium)			
153	164	sandy clay & little sand			
164	170	sand (medium)			

7 CONTRACTOR'S OR LANDOWNER'S CERTIFICATION: This water well was (1) constructed, (2) reconstructed, or (3) plugged under my jurisdiction and was completed on (mo/day/year) 10-1-93 and this record is true to the best of my knowledge and belief. Kansas Water Well Contractor's License No. 473 This Water Well Record was completed on (mo/day/yr) 10-1-93 under the business name of Tyler Water Well by (signature) [Signature]