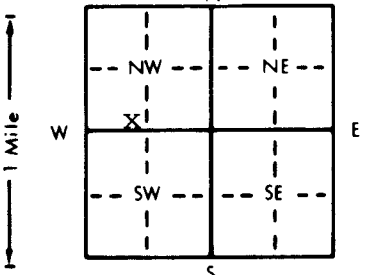


1 LOCATION OF WATER WELL: County: <u>Wichita</u>	Fraction <u>SE 1/4 SW 1/4 NW 1/4</u>	Section Number <u>10</u>	Township Number <u>T 17 S</u>	Range Number <u>R 38 E(W)</u>
---	---	-----------------------------	----------------------------------	----------------------------------

Distance and direction from nearest town or city street address of well if located within city?

2 WATER WELL OWNER: George C. Bauck
 RR#, St. Address, Box #: Rt #1 Box 75
 City, State, ZIP Code: Leoti, Ks. 67861
 Board of Agriculture, Division of Water Resources
 Application Number:

3 LOCATE WELL'S LOCATION WITH AN "X" IN SECTION BOX:

 4 DEPTH OF COMPLETED WELL: 84 ft. ELEVATION:
 Depth(s) Groundwater Encountered 1. 1 ft. 2. 62 ft. 3. 4-9-97 ft.
 WELL'S STATIC WATER LEVEL 62 ft. below land surface measured on mo/day/yr 4-9-97
 Pump test data: Well water was 15 gpm: Well water was 10 ft. after 84 hours pumping 15 gpm
 Est. Yield 15 gpm: Well water was 10 ft. after 84 hours pumping 15 gpm
 Bore Hole Diameter 10 in. to 84 ft., and 84 in. to 84 ft.
 WELL WATER TO BE USED AS:
 5 Public water supply 8 Air conditioning 11 Injection well
 1 Domestic 3 Feedlot 6 Oil field water supply 9 Dewatering 12 Other (Specify below) STOCK
 2 Irrigation 4 Industrial 7 Lawn and garden only 10 Monitoring well
 Was a chemical/bacteriological sample submitted to Department? Yes X No X; If yes, mo/day/yr sample was submitted 4-9-97
 Water Well Disinfected? Yes X No X

5 TYPE OF BLANK CASING USED:
 1 Steel 3 RMP (SR) 5 Wrought iron 8 Concrete tile CASING JOINTS: Glued X Clamped X
X PVC 4 ABS 6 Asbestos-Cement 9 Other (specify below) Welded X
 7 Fiberglass Threaded X
 Blank casing diameter 5 in. to 84 ft., Dia 5 in. to 84 ft., Dia 5 in. to 84 ft.
 Casing height above land surface 12 in., weight 12 lbs./ft. Wall thickness or gauge No. 200 psi
 TYPE OF SCREEN OR PERFORATION MATERIAL:
 1 Steel 3 Stainless steel 5 Fiberglass 8 RMP (SR) X PVC 10 Asbestos-cement
 2 Brass 4 Galvanized steel 6 Concrete tile 9 ABS 11 Other (specify) STOCK
 12 None used (open hole)
 SCREEN OR PERFORATION OPENINGS ARE:
 1 Continuous slot 3 Mill slot 5 Gauzed wrapped X Saw cut 11 None (open hole)
 2 Louvered shutter 4 Key punched 6 Wire wrapped 9 Drilled holes
 7 Torch cut 10 Other (specify) STOCK
 SCREEN-PERFORATED INTERVALS: From 64 ft. to 84 ft., From 64 ft. to 84 ft., From 64 ft. to 84 ft.
 GRAVEL PACK INTERVALS: From 25 ft. to 84 ft., From 25 ft. to 84 ft., From 25 ft. to 84 ft.

6 GROUT MATERIAL: 1 Neat cement 2 Cement grout X Bentonite chips 4 Other
 Grout Intervals: From 0 ft. to 25 ft., From 0 ft. to 25 ft., From 0 ft. to 25 ft.
 What is the nearest source of possible contamination:
 1 Septic tank 4 Lateral lines 7 Pit privy X Livestock pens 14 Abandoned water well
 2 Sewer lines 5 Cess pool 8 Sewage lagoon 11 Fuel storage 15 Oil well/Gas well
 3 Watertight sewer lines 6 Seepage pit 9 Feedyard 12 Fertilizer storage 16 Other (specify below)
 13 Insecticide storage
 Direction from well? How many feet? 500

FROM	TO	LITHOLOGIC LOG	FROM	TO	PLUGGING INTERVALS
0	1	top soil			
1	10	sandy clay			
10	15	coarse sand			
15	32	brown clay			
32	41	fine sand			
41	52	brown sandy clay			
52	61	fine sand			
61	81	fine to medium sand, few clay streaks			
81	84	brown clay			

7 CONTRACTOR'S OR LANDOWNER'S CERTIFICATION: This water well was X constructed, (2) reconstructed, or (3) plugged under my jurisdiction and was completed on (mo/day/year) 4-9-97 and this record is true to the best of my knowledge and belief. Kansas Water Well Contractor's License No. 532 This Water Well Record was completed on (mo/day/yr) 4-17-97 under the business name of Midwest Well & Pump by (signature) Victor Saubert