

WATER WELL RECORD

Form WWC-5


Division of Water Resources App. No.

1 LOCATION OF WATER WELL: County: <u>Wichita</u>	Fraction <u>¼ NE ¼ SE ¼ NE ¼</u>	Section Number <u>23</u>	Township No. <u>T 17 S</u>	Range Number <u>R 38</u> <input type="checkbox"/> E <input checked="" type="checkbox"/> W
--	-------------------------------------	-----------------------------	-------------------------------	--

Street/Rural Address of Well Location; if unknown, distance & direction from nearest town or intersection: If at owner's address, check here .
J Rd & 56 Rd. South 1360' South, 80' West

Global Positioning System (GPS) information:
Latitude: (in decimal degrees)
Longitude: (in decimal degrees)
Elevation:
Datum: WGS 84, NAD 83, NAD 27
Collection Method:
 GPS unit (Make/Model:)
 Digital Map/Photo, Topographic Map, Land Survey
Est. Accuracy: <3 m, 3-5 m, 5-15 m, >15 m

2 WATER WELL OWNER: Joe Bauck Jr.
RR#, Street Address, Box #: 646 N. County Rd. 6
City, State, ZIP Code : Leoti, KS 67861

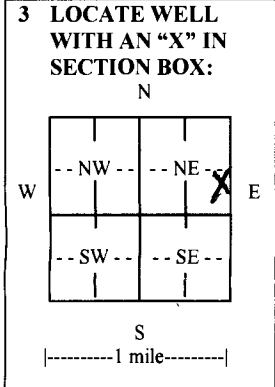

4 DEPTH OF COMPLETED WELL 200 ft.

Depth(s) Groundwater Encountered (1)..... ft. (2)..... ft. (3)..... ft.

WELL'S STATIC WATER LEVEL...152.....ft. below land surface measured on mo/day/yr.....

Pump test data: Well water was...158.....ft. after...4..... hours pumping...65..... gpm

EST. YIELD...100.....gpm. Well water was.....ft. after..... hours pumping..... gpm

Bore Hole Diameter 10.....in. to 200.....ft., andin. toft.

WELL WATER TO BE USED AS: Public water supply Geothermal Injection well
 Domestic Feedlot Oil field water supply Dewatering Other (Specify below)
 Irrigation Industrial Domestic-lawn & garden Monitoring well

Was a chemical/bacteriological sample submitted to Department? Yes No

If yes, mo/day/yr sample was submitted.....

Water well disinfected? Yes No

5 TYPE OF CASING USED: Steel PVC Other

CASING JOINTS: Glued Clamped Welded Threaded

Casing diameter 5..... in. to 175..... ft., Diameter in. to ft., Diameter in. to ft.

Casing height above land surface...18..... in., Weight 200.....lbs./ft., Wall thickness or gauge No. SDR21.....

TYPE OF SCREEN OR PERFORATION MATERIAL:
 Steel Stainless Steel PVC Other (Specify)
 Brass Galvanized Steel None used (open hole)

SCREEN OR PERFORATION OPENINGS ARE:
 Continuous slot Mill slot Gauze wrapped Torch cut Drilled holes None (open hole)
 Louvered shutter Key punched Wire wrapped Saw cut Other (specify)

SCREEN-PERFORATED INTERVALS: From...175..... ft. to 200..... ft., From ft. to ft.
From..... ft. to ft., From ft. to ft.

GRAVEL PACK INTERVALS: From...25..... ft. to 200..... ft., From ft. to ft.
From..... ft. to ft., From ft. to ft.

6 GROUT MATERIAL: Neat cement Cement grout Bentonite Other

Grout Intervals: From 5..... ft. to 25..... ft., From ft. to ft., From ft. to ft.

What is the nearest source of possible contamination:
 Septic tank Lateral lines Pit privy Livestock pens Insecticide storage Other (specify below)
 Sewer lines Cesspool Sewage lagoon Fuel storage Abandoned water well
 Watertight sewer lines Seepage pit Feedyard Fertilizer storage Oil well/gas well

Direction from well South..... Distance from well 1010'.....

FROM	TO	LITHOLOGIC LOG	FROM	TO	LITHO. LOG (cont.) or PLUGGING INTERVALS
0	2	Top Soil	162	176	Medium to Coarse Sand, Small Gravel
2	27	Brown Clay			Brown Clay Mix 50/50
27	42	Gypsum, Cemented Sand	176	194	Coarse Sand, Small to Medium Gravel
42	94	Brown Clay, Small Coarse Sand Str.			White Broken Rock
94	108	Medium to Coarse Sand, Small Gravel	194	200	Yellow Soap Stone
108	118	Light Sandy Brown Clay			
118	142	Medium to Coarse Sand, Small Gravel			
		Few Small Brown Clay Streaks			
142	148	Brown Clay, Few Small Sand Streaks			
148	162	Medium to Coarse Sand, Small Gravel			

7 CONTRACTOR'S OR LANDOWNER'S CERTIFICATION: This water well was constructed, reconstructed, or plugged under my jurisdiction and was completed on (mo/day/year) 5/1/15..... and this record is true to the best of my knowledge and belief. Kansas Water Well Contractor's License No. 692..... This Water Well Record was completed on (mo/day/year) 5/6/15..... under the business name of Midwest Well & Pump Inc...... by (signature) [Signature]

INSTRUCTIONS: Use typewriter or ball point pen. **PLEASE PRESS FIRMLY** and **PRINT** clearly. Please fill in blanks and check the correct answers. Send three copies (white, blue, pink) to Kansas Department of Health and Environment, Bureau of Water, Geology Section, 1000 SW Jackson St., Suite 420, Topeka, Kansas 66612-1367. Telephone 785-296-5522. Send one copy to WATER WELL OWNER and retain one for your records. Include fee of \$5.00 for each constructed well. Visit us at <http://www.kdheks.gov/waterwell/index.html>.