


#3 12002

WATER WELL PLUGGING RECORD Form WWC-5P KSA 82a-1212 ID NO.

1 LOCATION OF WATER WELL: County: WICHITA Fraction 1/4 NW 1/4 1/4 Section Number 22 Township Number T 17 S Range Number 30 E 24

Street/Rural Address of Well Location; if unknown, distance & direction from nearest town or intersection: If at owner's address, check here [] Global Positioning Systems (GPS) information: Latitude: (in decimal degrees) Longitude: (in decimal degrees) Elevation: Datum: [] WGS84, [] NAD83, [] NAD27 Collection Method: [] GPS unit (Make/Model): [] Digital Map/Photo, [] Topographic Map, [] Land Survey Est. Accuracy: [] < 3 m, [] 3-5 m, [] 5-15 m, [] > 15 m

2 WATER WELL OWNER: Thomas G. Bank + Michelle Bank RR#, St. Address, Box #: Revocable Trust 529 E. 39th Ct Hutcheson, KS 67502 City, State ZIP Code: [] GPS unit (Make/Model): [] Digital Map/Photo, [] Topographic Map, [] Land Survey Est. Accuracy: [] < 3 m, [] 3-5 m, [] 5-15 m, [] > 15 m

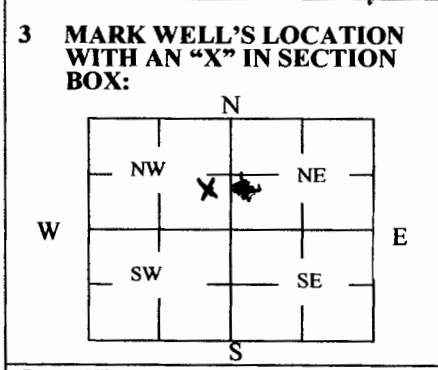

4 DEPTH OF WELL 102 ft. WELL'S STATIC WATER LEVEL 36 ft. WELL WAS USED AS: [X] Domestic [] Public Water Supply [] Dewatering [X] Irrigation [] Oil Field Water Supply [] Monitoring [] Feedlot [] Domestic (Lawn & Garden) [] Injection Well [] Industrial [] Air Conditioning [] Other Was a chemical/bacteriological sample submitted to Department? Yes [] No [X]

5 TYPE OF BLANK CASING USED: [X] Steel [] RMP (SR) [] Wrought [] Fiberglass [] Other (Specify below) [] PVC [] ABS [] Asbestos-Cement [] Concrete Tile Blank casing diameter 16 in. Was casing pulled? Yes [X] No [] If yes, how much 50' Casing height above or below land surface 50 in.

6 GROUT PLUG MATERIAL: [] Neat cement [] Cement grout [X] Bentonite [] Other Grout Plug Intervals: From 102 ft. to 41 ft., From 41 ft. to 7 ft., From 7 ft. to 4 ft. What is the nearest source of possible contamination: [X] Septic tank [] Seepage pit [] Fuel storage [] Other (specify below) [X] Sewer lines [] Pit privy [] Fertilizer storage [] Watertight sewer lines [] Sewage lagoon [] Insecticide storage [] Lateral lines [] Feedyard [] Abandoned water well [] Oil well/Gas well [] Cess pool [] Livestock pens Direction from well? N How many feet? 1400 ft.

Table with columns: FROM, TO, PLUGGING MATERIALS. Rows: 102 to 41 (Sand), 41 to 7 (Dirt), 7 to 4 (Bentonite), 4 to 0 (Dirt).

7 CONTRACTOR'S OR LANDOWNER'S CERTIFICATION: This water well was plugged under my jurisdiction and was completed on (mo/day/year) 12-76-17 and this record is true to the best of my knowledge and belief. Kansas Water Well Contractor's License No. This Water Well Record was completed on (mo/day/year) 12-16-17 under the business name of Jerry Crateson by (signature) Jerry Crateson

INSTRUCTIONS: Use typewriter or ballpoint pen. Please press firmly and print clearly. Please fill in blanks, underline or circle the correct answers. Send top three copies to Kansas Department of Health and Environment, Bureau of Water, Geology Section, 1000 SW Jackson St., Ste. 420, Topeka, Kansas 66612-1367. Telephone: 785/296-5524. Send one to Water Well Owner and retain one for your records. Visit us at http://www.kdheks.gov/waterwell/index.html.