


1 LOCATION OF WATER WELL: Fraction N 2 1/4 NE 1/4 NE 1/4 Section Number 10 Township Number T 17 S Range Number R 38 EW

Distance and direction from nearest town or city street address of well if located within city? 8 miles North 2 1/2 East of Selkirk

2 WATER WELL OWNER: FRANK W. BAUCK + MARGARET BAUCK
 RR#, St. Address, Box #: 2803 PEARLY JANE AVE. Board of Agriculture, Division of Water Resources
 City, State, ZIP Code: GARDEN CITY KANSAS 67864 Application Number: 11607

3 LOCATE WELL'S LOCATION WITH AN "X" IN SECTION BOX:

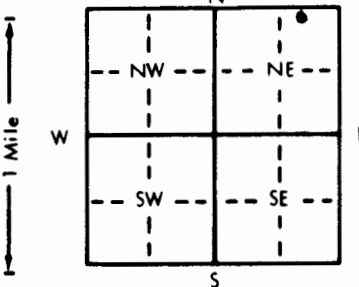

4 DEPTH OF COMPLETED WELL: 190 ft. ELEVATION: 125
 Depth(s) Groundwater Encountered 1. 125 ft. 2. _____ ft. 3. _____ ft.
 WELL'S STATIC WATER LEVEL 125 ft. below land surface measured on mo/day/yr
 Pump test data: Well water was _____ ft. after _____ hours pumping _____ gpm
 Est. Yield _____ gpm: Well water was _____ ft. after _____ hours pumping _____ gpm
 Bore Hole Diameter _____ in. to _____ ft., and _____ in. to _____ ft.
 WELL WATER TO BE USED AS:
 1 Domestic 3 Feedlot 6 Oil field water supply 9 Dewatering 11 Injection well
 2 Irrigation 4 Industrial 7 Lawn and garden only 10 Monitoring well 12 Other (Specify below) _____
 Was a chemical/bacteriological sample submitted to Department? Yes _____ No If yes, mo/day/yr sample was submitted _____
 Water Well Disinfected? Yes _____ No

5 TYPE OF CASING USED:
 1 Steel _____ 3 RMP (SR) _____ 5 Wrought iron _____ 8 Concrete tile _____ CASING JOINTS: Glued _____ Clamped _____
 2 PVC _____ 4 ABS _____ 6 Asbestos-Cement _____ 9 Other (specify below) _____ Welded _____
 7 Fiberglass _____ Threaded _____
 Blank casing diameter NA in. to _____ ft., Dia _____ in. to _____ ft., Dia _____ in. to _____ ft.
 Casing height above land surface 4' below grade in., weight _____ lbs./ft. Wall thickness or gauge No. _____

TYPE OF SCREEN OR PERFORATION MATERIAL:
 1 Steel _____ 3 Stainless steel _____ 5 Fiberglass _____ 8 RMP (SR) _____ 11 Other (specify) NA
 2 Brass _____ 4 Galvanized steel _____ 6 Concrete tile _____ 9 ABS _____ 12 None used (open hole) _____

SCREEN OR PERFORATION OPENINGS ARE:
 1 Continuous slot _____ 3 Mill slot _____ 5 Gauzed wrapped _____ 8 Saw cut _____ 11 None (open hole) _____
 2 Louvered shutter _____ 4 Key punched _____ 6 Wire wrapped _____ 9 Drilled holes _____
 7 Torch cut _____ 10 Other (specify) NA _____

SCREEN-PERFORATED INTERVALS: From _____ ft. to _____ ft., From _____ ft. to _____ ft.
 From _____ ft. to _____ ft., From _____ ft. to _____ ft.
 GRAVEL PACK INTERVALS: From _____ ft. to _____ ft., From _____ ft. to _____ ft.
 From _____ ft. to _____ ft., From _____ ft. to _____ ft.

6 GROUT MATERIAL: 1 Neat cement _____ 2 Cement grout _____ 3 Bentonite _____ 4 Other _____
 Grout Intervals: From 4 ft. to 2 ft., From _____ ft. to _____ ft., From _____ ft. to _____ ft.

What is the nearest source of possible contamination:
 1 Septic tank _____ 4 Lateral lines _____ 7 Pit privy _____ 10 Livestock pens _____ 14 Abandoned water well _____
 2 Sewer lines _____ 5 Cess pool _____ 8 Sewage lagoon _____ 11 Fuel storage _____ 15 Oil well/Gas well _____
 3 Watertight sewer lines _____ 6 Seepage pit _____ 9 Feedyard _____ 12 Fertilizer storage _____ 16 Other (specify below) NA _____
 13 Insecticide storage _____

Direction from well? _____ How many feet? _____

FROM	TO	LITHOLOGIC LOG	FROM	TO	PLUGGING INTERVALS
			<u>190 ft</u>	<u>125 ft</u>	<u>Clean sand + gravel</u>
			<u>125 ft</u>	<u>4 ft</u>	<u>dirt</u>
			<u>4 ft</u>	<u>2 ft above ground level</u>	<u>concrete</u>
			<u>2</u>	<u>0</u>	<u>Clay</u>

7 CONTRACTOR'S OR LANDOWNER'S CERTIFICATION: This water well was (1) constructed, (2) reconstructed, or (3) plugged under my jurisdiction and was completed on (mo/day/year) 9-15-89 and this record is true to the best of my knowledge and belief. Kansas Water Well Contractor's License No. _____ This Water Well Record was completed on (mo/day/yr) 6-10-90 under the business name of _____ by (signature) Frank W. Bauck

OFFICE USE ONLY
T
R
EW
SEC.
1/4
1/4
1/4