


1 LOCATION OF WATER WELL: Fraction SE 1/4 NE 1/4 NE 1/4 Section Number 13 Township Number T 17 S Range Number R 38 EW  
 County: Wichita  
 Distance and direction from nearest town or city street address of well if located within city?

5 miles West 6 3/4 miles North of Leoti, Kansas

2 WATER WELL OWNER: Robert Bangertter Board of Agriculture, Division of Water Resources  
 RR#, St. Address, Box #: R R 1 Application Number:  
 City, State, ZIP Code: Leoti, Kansas 67861

3 LOCATE WELL'S LOCATION WITH AN "X" IN SECTION BOX:

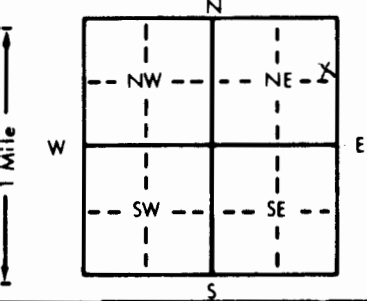

4 DEPTH OF COMPLETED WELL... 151 ft. ELEVATION:  
 Depth(s) Groundwater Encountered 1... 84 ft. 2... ft. 3... ft.  
 WELL'S STATIC WATER LEVEL 84 ft. below land surface measured on mo/day/yr 3/9/82  
 NA Pump test data: Well water was ... ft. after ... hours pumping ... gpm  
 Est. Yield ... gpm: Well water was ... ft. after ... hours pumping ... gpm  
 Bore Hole Diameter... in. to ... ft., and ... in. to ... ft.  
 WELL WATER TO BE USED AS: 5 Public water supply 8 Air conditioning 11 Injection well  
 Domestic 3 Feedlot 6 Oil field water supply 9 Dewatering ~~12 Other~~ (Specify below)  
 2 Irrigation 4 Industrial 7 Lawn and garden only 10 Observation well Stockwell  
 Was a chemical/bacteriological sample submitted to Department? Yes... No...  No...; If yes, mo/day/yr sample was submitted  
 Water Well Disinfected? Yes  No

5 TYPE OF BLANK CASING USED:  
 1 Steel 3 RMP (SR) 5 Wrought iron 8 Concrete tile CASING JOINTS: Glued Clamped  
 2 PVC 4 ABS 6 Asbestos-Cement 9 Other (specify below) Welded  
 7 Fiberglass Threaded

Blank casing diameter... 5 in. to... 131 ft., Dia... in. to... ft., Dia... in. to... ft.  
 Casing height above land surface... 12 in., weight... 2.368 lbs./ft. Wall thickness or gauge No. .214

TYPE OF SCREEN OR PERFORATION MATERIAL:  
 1 Steel 3 Stainless steel 5 Fiberglass 7 PVC 10 Asbestos-cement  
 2 Brass 4 Galvanized steel 6 Concrete tile 8 RMP (SR) 11 Other (specify)  
 12 None used (open hole)

SCREEN OR PERFORATION OPENINGS ARE:  
 1 Continuous slot 3 Mill slot 5 Gauzed wrapped 8 Saw cut 11 None (open hole)  
 2 Louvered shutter 4 Key punched 6 Wire wrapped 9 Drilled holes  
 7 Torch cut 10 Other (specify)

SCREEN-PERFORATED INTERVALS: From... 131 ft. to... 151 ft., From... ft. to... ft.  
 GRAVEL PACK INTERVALS: From... 100 ft. to... 151 ft., From... ft. to... ft.

6 GROUT MATERIAL: 1 Neat cement 2 Cement grout 3 Bentonite 4 Other Drill Cuttings  
 Grout Intervals: From... 15 ft. to... 100 ft., From... 4 ft. to... 15 ft., From... ft. to... ft.

What is the nearest source of possible contamination:  
 Septic tank 4 Lateral lines 7 Pit privy 10 Livestock pens 14 Abandoned water well  
 2 Sewer lines 5 Cess pool 8 Sewage lagoon 11 Fuel storage 15 Oil well/Gas well  
 3 Watertight sewer lines 6 Seepage pit 9 Feedyard 12 Fertilizer storage 16 Other (specify below)  
 13 Insecticide storage

Direction from well? South How many feet? 400

FROM	TO	LITHOLOGIC LOG	FROM	TO	LITHOLOGIC LOG
0	49	Clay	49	68	Sandy clay
68	75	Sand rock	75	84	Fine sand
84	89	Sand Rock	89	99	Fine Sand
99	106	Sand	106	114	Fine sand clay streaks
114	141	Fine sand	141	147	Sand & Gravel
147	151	Yellow clay			

7 CONTRACTOR'S OR LANDOWNER'S CERTIFICATION: This water well was (1) constructed (2) reconstructed, or (3) plugged under my jurisdiction and was completed on (mo/day/year) ... 3/10/82 ... and this record is true to the best of my knowledge and belief. Kansas Water Well Contractor's License No. 232 This Water Well Record was completed on (mo/day/yr) ... 3/12/82 ...

under the business name of Weishaar Drilling & Supply Inc. by (signature) Rayel Houston  
 INSTRUCTIONS: Use typewriter or ball point pen, PLEASE PRESS FIRMLY and PRINT clearly. Please fill in blanks, underline or circle the correct answers. Send top three copies to Kansas Department of Health and Environment, Division of Environment, Environmental Geology Section, Topeka, KS 66620. Send one to WATER WELL OWNER and retain one for your records.

OFFICE USE ONLY T 17 R 38 EW SEC. 13 SE 1/4 NE 1/4 NE 1/4