

1 LOCATION OF WATER WELL: Fraction SW 1/4 SW 1/4 NE 1/4 Section Number 34 Township Number T 17 S Range Number R 38 W


Distance and direction from nearest town or city street address of well if located within city?

6 West, 3 North, 1 West, 1 North, 1/2 West, 1/2 North, & 1/8 mile East of Leoti

2 WATER WELL OWNER: Mrs. Frank E. Whitham RR#, St. Address, Box #: R2 Box 200 City, State, ZIP Code: Leoti, Kansas 67861

Board of Agriculture, Division of Water Resources Application Number: 10225

3 LOCATE WELL'S LOCATION WITH AN "X" IN SECTION BOX: DEPTH OF COMPLETED WELL: 200 ft. ELEVATION: 3200

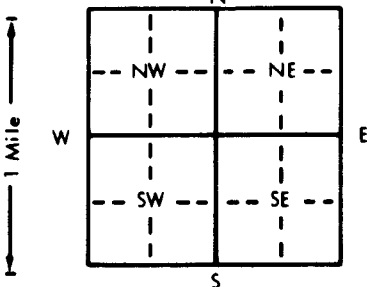

Depth(s) Groundwater Encountered 1. 145 ft. 2. ft. 3. ft. WELL'S STATIC WATER LEVEL 145 ft. below land surface measured on mo/day/yr Pump test data: Well water was ft. after hours pumping gpm Est. Yield gpm: Well water was ft. after hours pumping gpm Bore Hole Diameter in. to ft., and in. to ft. WELL WATER TO BE USED AS: 5 Public water supply 8 Air conditioning 11 Injection well 1 Domestic 3 Feedlot 6 Oil field water supply 9 Dewatering 12 Other (Specify below) 2 Irrigation 4 Industrial 7 Lawn and garden only 10 Monitoring well Was a chemical/bacteriological sample submitted to Department? Yes No checked; If yes, mo/day/yr sample was submitted Water Well Disinfected? Yes checked No

5 TYPE OF BLANK CASING USED: 1 Steel 3 RMP (SR) 6 Asbestos-Cement 9 Other (specify below) 2 PVC 4 ABS 7 Fiberglass CASING JOINTS: Glued Clamped Welded checked Threaded

Blank casing diameter 16 in. to 0-? ft., Dia. in. to ft., Dia. in. to ft. Casing height above land surface in., weight lbs./ft. Wall thickness or gauge No. 2.50

TYPE OF SCREEN OR PERFORATION MATERIAL: 1 Steel 3 Stainless steel 5 Fiberglass 8 RMP (SR) 11 Other (specify) NA 2 Brass 4 Galvanized steel 6 Concrete tile 9 ABS 12 None used (open hole)

SCREEN OR PERFORATION OPENINGS ARE: 1 Continuous slot 3 Mill slot 5 Gauzed wrapped 8 Saw cut 11 None (open hole) 2 Louvered shutter 4 Key punched 6 Wire wrapped 9 Drilled holes 10 Other (specify) NA 7 Torch cut NA

SCREEN-PERFORATED INTERVALS: From NA ft. to NA ft., From ft. to ft. GRAVEL PACK INTERVALS: From ft. to ft., From ft. to ft.

6 GROUT MATERIAL: 1 Neat cement 2 Cement grout 3 Bentonite 4 Other Grout Intervals: From 8 ft. to 14 ft., From ft. to ft., From ft. to ft.

What is the nearest source of possible contamination: 1 Septic tank 4 Lateral lines 7 Pit privy 11 Fuel storage 15 Oil well/Gas well 2 Sewer lines 5 Cess pool 8 Sewage lagoon 12 Fertilizer storage 16 Other (specify below) 3 Watertight sewer lines 6 Seepage pit 9 Feedyard 13 Insecticide storage None checked

Direction from well? How many feet?

Table with columns: FROM, TO, LITHOLOGIC LOG, FROM, TO, PLUGGING INTERVALS. Handwritten entries: 0-8 Top Soil, 8-14 Bentonite grout, 14-145 Top Soil, 145-200 chlorinated sand

7 CONTRACTOR'S OR LANDOWNER'S CERTIFICATION: This water well was (1) constructed, (2) reconstructed, or (3) plugged under my jurisdiction and was completed on (mo/day/year) 10/20/92 and this record is true to the best of my knowledge and belief. Kansas Water Well Contractor's License No. This Water Well Record was completed on (mo/day/year) 10/31/92 under the business name of by (signature) Jani Whitham