


1 LOCATION OF WATER WELL: County: Wichita Fraction SW  $\frac{1}{4}$  SW  $\frac{1}{4}$  SE  $\frac{1}{4}$  Section Number XX 34 Township Number T 17 S Range Number R 38 E/W

Distance and direction from nearest town or city street address of well if located within city?  
6 west, 3 north, 1 west, 1 north of Leoti Kansas

2 WATER WELL OWNER: Stewart Whitham  
 RR#, St. Address, Box # Rural Route 2 Box 200 Board of Agriculture, Division of Water Resources  
 City, State, ZIP Code Leoti, Kansas 67861 Application Number: 34466

3 LOCATE WELL'S LOCATION WITH AN "X" IN SECTION BOX:

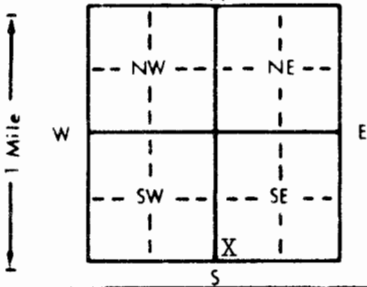

4 DEPTH OF COMPLETED WELL: 205 ft. ELEVATION: 3425

Depth(s) Groundwater Encountered 1. 160 ft. 2. \_\_\_\_\_ ft. 3. \_\_\_\_\_ ft.  
 WELL'S STATIC WATER LEVEL 160 ft. below land surface measured on mo/day/yr 6-5-95  
 Pump test data: Well water was 201 ft. after 3 hours pumping 240 gpm  
 Est. Yield 240 gpm: Well water was \_\_\_\_\_ ft. after \_\_\_\_\_ hours pumping \_\_\_\_\_ gpm  
 Bore Hole Diameter 26 in. to 205 ft., and \_\_\_\_\_ in. to \_\_\_\_\_ ft.  
 WELL WATER TO BE USED AS:  
 5 Public water supply 8 Air conditioning 11 Injection well  
 1 Domestic 3 Feedlot 6 Oil field water supply 9 Dewatering 12 Other (Specify below)  
 2 Irrigation 4 Industrial 7 Lawn and garden only 10 Monitoring well  
 Was a chemical/bacteriological sample submitted to Department? Yes \_\_\_\_\_ No X; If yes, mo/day/yr sample was submitted \_\_\_\_\_  
 Water Well Disinfected? Yes X No \_\_\_\_\_

5 TYPE OF BLANK CASING USED:  
 1 Steel 3 RMP (SR) 5 Wrought iron 8 Concrete tile CASING JOINTS: Glued X Clamped \_\_\_\_\_  
 2 PVC 4 ABS 6 Asbestos-Cement 9 Other (specify below) Welded \_\_\_\_\_  
 7 Fiberglass Threaded \_\_\_\_\_

Blank casing diameter 12 in. to 165 ft. Dia \_\_\_\_\_ in. to \_\_\_\_\_ ft. Dia \_\_\_\_\_ in. to \_\_\_\_\_ ft.  
 Casing height above land surface 12 in., weight \_\_\_\_\_ lbs./ft. Wall thickness or gauge No. Sch 40

TYPE OF SCREEN OR PERFORATION MATERIAL:  
 1 Steel 3 Stainless steel 5 Fiberglass 8 RMP (SR) 10 Asbestos-cement 11 Other (specify) \_\_\_\_\_  
 2 Brass 4 Galvanized steel 6 Concrete tile 9 ABS 12 None used (open hole)

SCREEN OR PERFORATION OPENINGS ARE:  
 1 Continuous slot 3 Mill slot 5 Gauzed wrapped 8 Saw cut 11 None (open hole)  
 2 Louvered shutter 4 Key punched 6 Wire wrapped 9 Drilled holes  
 7 Torch cut 10 Other (specify) \_\_\_\_\_

SCREEN-PERFORATED INTERVALS: From 165 ft. to 205 ft., From \_\_\_\_\_ ft. to \_\_\_\_\_ ft., From \_\_\_\_\_ ft. to \_\_\_\_\_ ft.  
 GRAVEL PACK INTERVALS: From 25 ft. to 205 ft., From \_\_\_\_\_ ft. to \_\_\_\_\_ ft., From \_\_\_\_\_ ft. to \_\_\_\_\_ ft.

6 GROUT MATERIAL: 1 Neat cement 2 Cement grout 3 Bentonite 4 Other \_\_\_\_\_  
 Grout Intervals: From 5 ft. to 20 ft., From \_\_\_\_\_ ft. to \_\_\_\_\_ ft., From \_\_\_\_\_ ft. to \_\_\_\_\_ ft.

What is the nearest source of possible contamination:  
 1 Septic tank 4 Lateral lines 7 Pit privy 10 Livestock pens 14 Abandoned water well  
 2 Sewer lines 5 Cess pool 8 Sewage lagoon 11 Fuel storage 15 Oil well/Gas well  
 3 Watertight sewer lines 6 Seepage pit 9 Feedyard 12 Fertilizer storage 16 Other (specify below)  
 13 Insecticide storage  
 Direction from well? West How many feet? 290

FROM	TO	LITHOLOGIC LOG	FROM	TO	PLUGGING INTERVALS
0	12	Top Soil and Clay	182	184	Sand (medium)
12	16	Limestone	184	185	Clay
16	49	Limestone (hard)	185	188	Sand (medium-course)
49	65	Limestone and Cemented Sand (hard)	188	196	Clay
65	82	Sand and Sandy Clay	196	200	Sand (course-loose)
82	110	Sandy Clay	200	204	Yellow Clay
110	114	Sand	204	211	Shale
114	140	Sandy Clay			
140	146	Sand (medium)			
146	147	Clay			
147	164	Sand (med-crs) and 2' Clay			
164	170	Sand (medium)			
170	171	Clay			
171	180	Sand (medium)			
180	182	Clay			

7 CONTRACTOR'S OR LANDOWNER'S CERTIFICATION: This water well was (1) constructed, (X) reconstructed, or (X) plugged under my jurisdiction and was completed on (mo/day/year) 6-2-95 and this record is true to the best of my knowledge and belief. Kansas Water Well Contractor's License No. 473. This Water Well Record was completed on (mo/day/yr) 6-6-95 under the business name of Tyler Water Well Service by (signature) Daryl Ely

INSTRUCTIONS: Use typewriter or ball point pen. PLEASE PRESS FIRMLY and PRINT clearly. Please fill in blanks, underline or circle the correct answers. Send top three copies to Kansas Department of Health and Environment, Bureau of Water, Topeka, Kansas 66620-0001. Telephone: 913-296-5545. Send one to WATER WELL OWNER and retain one for your records.

OFFICE USE ONLY T R E/W SEC. 1/4 1/4 1/4