


1] LOCATION OF WATER WELL: County: Greene Fraction: SE 1/4 SE 1/4 NE 1/4 Section Number: 3 Township Number: T 17 S Range Number: R 39 E

Distance and direction from nearest town or city street address of well if located within city?  
9 1/2 N 8 E of Tribune

2] WATER WELL OWNER: Bill Kleyman  
 RR#, St. Address, Box #: Tribune Ks. 67879  
 City, State, ZIP Code: Tribune Ks. 67879  
 Board of Agriculture, Division of Water Resources  
 Application Number:

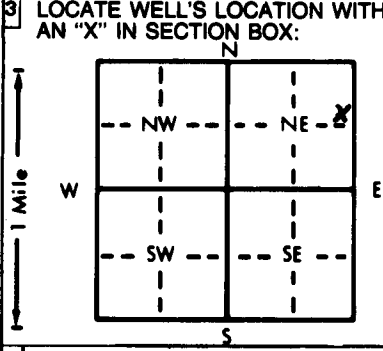

4] DEPTH OF COMPLETED WELL: 150 ft. ELEVATION: 3620  
 Depth(s) Groundwater Encountered 1. 87' ft. 2. 87' ft. 3. 87' ft.  
 WELL'S STATIC WATER LEVEL 87' ft. below land surface measured on mo/day/yr 5-2-86  
 Pump test data: Well water was 100' ft. after 6 hours pumping 20 gpm  
 Est. Yield 35 gpm Well water was 100' ft. after 6 hours pumping 20 gpm  
 Bore Hole Diameter 8 in. to 40 ft., and 6 1/2 in. to 150 ft.  
 WELL WATER TO BE USED AS:  
 1 Domestic     3 Feedlot     6 Oil field water supply     9 Dewatering     12 Other (Specify below)  
 2 Irrigation     4 Industrial     7 Lawn and garden only     10 Observation well  
 Was a chemical/bacteriological sample submitted to Department? Yes.....No.....; If yes, mo/day/yr sample was submitted  
 Water Well Disinfected? Yes No

5] TYPE OF BLANK CASING USED:  
 1 Steel     3 RMP (SR)     5 Wrought iron     8 Concrete tile    CASING JOINTS: Glued ..... Clamped .....  
 2 PVC     4 ABS     6 Asbestos-Cement     9 Other (specify below)    Welded ..... X .....  
 7 Fiberglass    Threaded.....  
 Blank casing diameter 5" in. to 110 ft., Dia ..... in. to ..... ft., Dia ..... in. to ..... ft.  
 Casing height above land surface 18 in., weight 10.5 lbs./ft. Wall thickness or gauge No. 219

TYPE OF SCREEN OR PERFORATION MATERIAL:  
 1 Steel     3 Stainless steel     5 Fiberglass     8 RMP (SR)     11 Other (specify) .....  
 2 Brass     4 Galvanized steel     6 Concrete tile     9 ABS     12 None used (open hole)  
 SCREEN OR PERFORATION OPENINGS ARE:  
 1 Continuous slot     3 Mill slot     5 Gauzed wrapped     8 Saw cut     11 None (open hole)  
 2 Louvered shutter     4 Key punched     6 Wire wrapped     9 Drilled holes  
 7 Torch cut     10 Other (specify) .....  
 SCREEN-PERFORATED INTERVALS: From 110' ft. to 140' ft., From ..... ft. to ..... ft.  
 From ..... ft. to ..... ft., From ..... ft. to ..... ft.  
 GRAVEL PACK INTERVALS: From 80 ft. to 140' ft., From ..... ft. to ..... ft.  
 From ..... ft. to ..... ft., From ..... ft. to ..... ft.

6] GROUT MATERIAL:  1 Neat cement     2 Cement grout     3 Bentonite     4 Other .....  
 Grout intervals: From 6' ft. to 26' ft., From ..... ft. to ..... ft., From ..... ft. to ..... ft.  
 What is the nearest source of possible contamination:  
 1 Septic tank     4 Lateral lines     7 Pit privy     10 Livestock pens     14 Abandoned water well  
 2 Sewer lines     5 Cess pool     8 Sewage lagoon     11 Fuel storage     15 Oil well/Gas well  
 3 Watertight sewer lines     6 Seepage pit     9 Feedyard     12 Fertilizer storage     16 Other (specify below)  
 13 Insecticide storage .....  
 Direction from well? How many feet? 200'

FROM	TO	LITHOLOGIC LOG	FROM	TO	LITHOLOGIC LOG
0	15	Top Soil			
15	19	Sand			
19	30	Clay			
30	60	Sandy Clay			
60	71	Clay			
71	77	Sand			
77	100	Sandy Clay			
100	118	cemented Sand very hard			
118	129	Clay			
129	140	Sand			
140	150	Clay			
150		Shale			

7] CONTRACTOR'S OR LANDOWNER'S CERTIFICATION: This water well was (1) constructed, (2) reconstructed, or (3) plugged under my jurisdiction and was completed on (mo/day/year) 5-8-86 and this record is true to the best of my knowledge and belief. Kansas Water Well Contractor's License No. 473 This Water Well Record was completed on (mo/day/yr) 5-8-86 under the business name of Tyler Water Well by (signature) Tyler

INSTRUCTIONS: Use typewriter or ball point pen. PLEASE PRESS FIRMLY and PRINT clearly. Please fill in blanks, underline or circle the correct answers. Send top three copies to Kansas Department of Health and Environment, Office of Oil Field and Environmental Geology, Regulation and Permitting Section, Topeka, Kansas 66620-7500, Telephone: 913-862-9360. Send one to WATER WELL OWNER and retain one for your records.