

SHARON SPRINGS USE

USE TYPEWRITER OR BALL POINT PEN-PRESS FIRMLY, PRINT CLEARLY.


WATER WELL RECORD
KSA 82a-1201-1215

Kansas Department of Health and Environment-Division of Environment
(Water well Contractors)
Topeka, Kansas 66620

CBB

1. Location of well: well # 1	County Greeley	Fraction NW 1/4 NW 1/4 SW 1/4	Section number 10	Township number T 17	Range number S R 39	E W
-----------------------------------------	--------------------------	-----------------------------------------	-----------------------------	--------------------------------	-------------------------------	------------

2. Distance and direction from nearest town or city: 8 mi. north & 6 mi east of Tribune Kansas	3. Owner of well: Robert Kleyman
Street address of well location if in city: Kansas	R. or street: Tribune, Kansas 67879
City, state, zip code: Tribune, Kansas 67879	

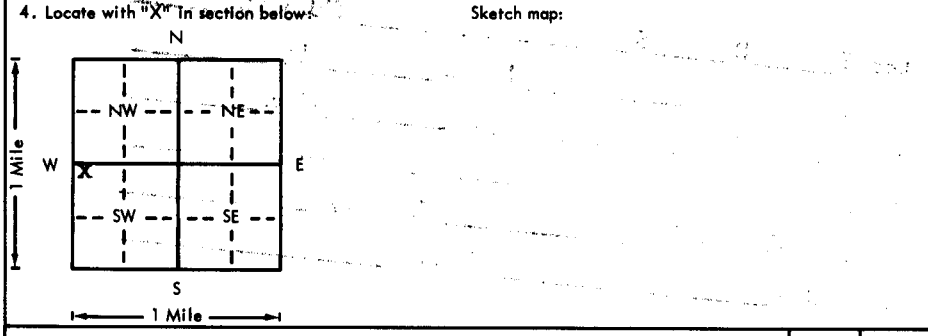

6. Bore hole dia. <u>26</u> in. Completion date _____ Well depth <u>207</u> ft. <u>5-20-77</u>
7. Cable tool <input type="checkbox"/> Rotary <input type="checkbox"/> Driven <input type="checkbox"/> Dug <input type="checkbox"/> <input type="checkbox"/> Hollow rod <input type="checkbox"/> Jetted <input type="checkbox"/> Bored <input checked="" type="checkbox"/> Reverse rotary
8. Use: <input type="checkbox"/> Domestic <input type="checkbox"/> Public supply <input type="checkbox"/> Industry <input checked="" type="checkbox"/> Irrigation <input type="checkbox"/> Air conditioning <input type="checkbox"/> Stock <input type="checkbox"/> Lawn <input type="checkbox"/> Oil field water <input type="checkbox"/> Other
9. Casing: Material <u>steel</u> Height: Above or below Threaded <input type="checkbox"/> Welded <input checked="" type="checkbox"/> Surface <u>12</u> in. RMP <input type="checkbox"/> PVC <input type="checkbox"/> Weight <u>40</u> lbs./ft. Dia. <u>16</u> in. to <u>167</u> ft. depth Wall Thickness: inches or Dia. <u>167</u> in. to <u>207</u> ft. depth gage No. <u>.219</u>

5. Type and color of material	From	To
Top soil & Clay	0	13
Clay & line	13	30
Clay & little line (hard)	30	75
Clay & little sand	75	90
Clay & sand	90	105
Clay	105	145
Clay & sand	145	150
Clay & little line	150	154
Sand	154	161
Clay	161	174
Sand & Clay	174	180
Sand	180	183
Clay	183	195
Sand	195	199
Clay	199	204
Shale (blue)	204	207

10. Screen: Manufacturer's name <u>W. A. Brown</u> Type <u>Perf. steel</u> Dia. <u>16"</u> Slot <u>2"</u> Length <u>40 ft.</u> Set between <u>167</u> ft. and <u>207</u> ft. Gravel pack? <u>yes</u> Size range of material <u>1/4 to 5/8</u>
11. Static water level: _____ mo./day/yr. <u>115</u> ft. below land surface Date <u>5-13-77</u>
12. Pumping level below land surfaces: <u>200</u> ft. after <u>3</u> hrs. pumping <u>600</u> g.p.m. _____ ft. after _____ hrs. pumping _____ g.p.m. Estimated maximum yield <u>600</u> g.p.m.
13. Water sample submitted: _____ mo./day/yr. Yes <input checked="" type="checkbox"/> No <input type="checkbox"/> Date _____
14. Well head completion: <input type="checkbox"/> Pitless adapter <u>12</u> inches above grade
15. Well grouted? <u>yes</u> With: <input type="checkbox"/> Neat cement <input type="checkbox"/> Bentonite <input checked="" type="checkbox"/> Concrete Depth: From <u>0</u> ft. to <u>10</u> ft.
16. Nearest source of possible contamination: ft. _____ Direction _____ Type <u>None</u> Well disinfected upon completion? <input type="checkbox"/> Yes <input checked="" type="checkbox"/> No
17. Pump: _____ Not installed Manufacturer's name <u>Layne</u> Model number <u>770328</u> HP _____ Volts _____ Length of drop pipe <u>200</u> ft. capacity <u>500</u> g.p.m. Type: <input type="checkbox"/> Submersible <input checked="" type="checkbox"/> Turbine <input type="checkbox"/> Jet <input type="checkbox"/> Reciprocating <input type="checkbox"/> Centrifugal <input type="checkbox"/> Other

18. Elevation: Topography: <input type="checkbox"/> Hill <input type="checkbox"/> Slope <input type="checkbox"/> Upland <input type="checkbox"/> Valley	19. Remarks: <u>BROCK 195'</u> <u>3533 (TOPO)</u>
---	---------------------------------------------------------

20. Water well contractor's certification: This well was drilled under my jurisdiction and this report is true to the best of my knowledge and belief. ARK VALLEY PUMP & SUPPLY 123 Business name <u>Holly, Colo. 81047</u> Address _____ Signed <u>[Signature]</u> Date _____ Authorized representative

17 39 E L O NW NW SW
T
R
Sec
1/4 1/4 1/4