


USE TYPEWRITER OR BALL POINT PEN-PRESS FIRMLY, PRINT CLEARLY.

WATER WELL RECORD  
KSA 82a-1201-1215

Kansas Department of Health and Environment-Division of Environment  
(Water well Contractors)  
Topeka, Kansas 66620

1. Location of well: **well # 2**  
 County: **Greeley** Fraction: **SW 1/4 SW 1/4 SW 1/4** Section number: **14** Township number: **T 17 S R 39** Range number: **X/W**

2. Distance and direction from nearest town or city: **7 mi. North & 8 east of Tribune, Kansas**  
 Street address of well location if in city: **Kansas**  
 3. Owner of well: **Fred Kleyman**  
 R.R. or street: **Tribune, Kansas 67879**  
 City, state, zip code: **Tribune, Kansas 67879**

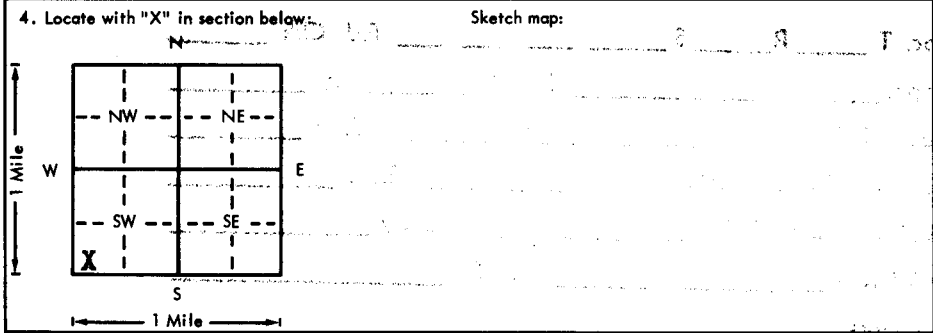

6. Bore hole dia. **26** in. Completion date **5-23-77**  
 Well depth **183** ft.

7.  Cable tool  Rotary  Driven  Dug  
 Hollow rod  Jetted  Bored  Reverse rotary

8. Use:  Domestic  Public supply  Industry  
 Irrigation  Air conditioning  Stock  
 Lawn  Oil field water  Other

9. Casing: Material **steel** Height: Above or ~~XXX~~  
 Threaded  Welded  Surface **12** in.  
 RMP  PVC  Weight **40** lbs./ft.  
 Dia. **16** in. to **143** ft. depth Wall Thickness: inches or  
 Dia. **143** in. to **183** ft. depth gage No. **219**

5. Type and color of material	From	To
Overburden	0	135
Cemented sand (hard)	135	137
Clay	137	141
Sand	141	147
Clay & fine sand	147	165
Sand	165	175
Clay (yellow)	175	181
Shale (blue)	181	183
(Use a second sheet if needed)		

10. Screen: Manufacturer's name \_\_\_\_\_  
 Type **Perf. steel** Dia. **16 in.**  
 Slot/ ~~max~~ **2"** Length **40 ft.**  
 Set between **143** ft. and **183** ft.  
 \_\_\_\_\_ ft. and \_\_\_\_\_ ft.  
 Gravel pack **yes** Size range of material **1/4 to 5/8**

11. Static water level: \_\_\_\_\_ mo./day/yr.  
**115** ft. below land surface Date **5-20-77**

12. Pumping level below land surfaces:  
**180** ft. after **5** hrs. pumping **600** g.p.m.  
 \_\_\_\_\_ ft. after \_\_\_\_\_ hrs. pumping \_\_\_\_\_ g.p.m.  
 Estimated maximum yield **600** g.p.m.

13. Water sample submitted: \_\_\_\_\_ mo./day/yr.  
 Yes  No  Date \_\_\_\_\_

14. Well head completion:  
 Pitless adapter **12** inches above grade

15. Well grouted? **yes**  
 With:  Near cement  Bentonite  Concrete  
 Depth: From **0** ft. to **10** ft.

16. Nearest source of possible contamination:  
 ft. \_\_\_\_\_ Direction \_\_\_\_\_ Type **none**  
 Well disinfected upon completion?  Yes  No

17. Pump: \_\_\_\_\_ Not installed  
 Manufacturer's name **Layne**  
 Model number **81450K** HP \_\_\_\_\_ Volts \_\_\_\_\_  
 Length of drop pipe **180** ft. capacity **600** g.p.m.  
 Type:  
 Submersible  Turbine  
 Jet  Reciprocating  
 Centrifugal  Other

18. Elevation:  
 Topography:  
 Hill  
 Slope  
 Upland  
 Valley

19. Remarks:  
**Level ground**

20. Water well contractor's certification:  
 This well was drilled under my jurisdiction and this report is true to the best of my knowledge and belief.  
**Ark Valley Pump & Supply 123**  
 Business name **Holly, Colo, 81047** License No. \_\_\_\_\_  
 Address \_\_\_\_\_  
 Signed **Wendy Smith** Date **7-1-77**  
 Authorized representative

T 17 S R 39 E 14 SW/4 Sec 1/4 1/4 1/4