

USE TYPEWRITER OR BALL POINT PEN-PRESS FIRMLY, PRINT CLEARLY.


WATER WELL RECORD
KSA 82a-1201-1215

Kansas Department of Health and Environment-Division of Environment
(Water well Contractors)
Topeka, Kansas 66620

ASW

1. Location of well: County **Greeley** Fraction **N/E 1/4 N/E 1/4 S/W 1/4** Section number **17** Township number **T 17** Range number **S R 39** #/W

2. Distance and direction from nearest town or city: **8 1/2 N, 1 1/2 E. of Whitelaw, Kansas** Street address of well location if in city:
3. Owner of well: **Lemon Farms** R.R. or street: **Stanley C. Smith, Mgr.** City, state, zip code: **Box # 1, Garden City, Kans. 67846**

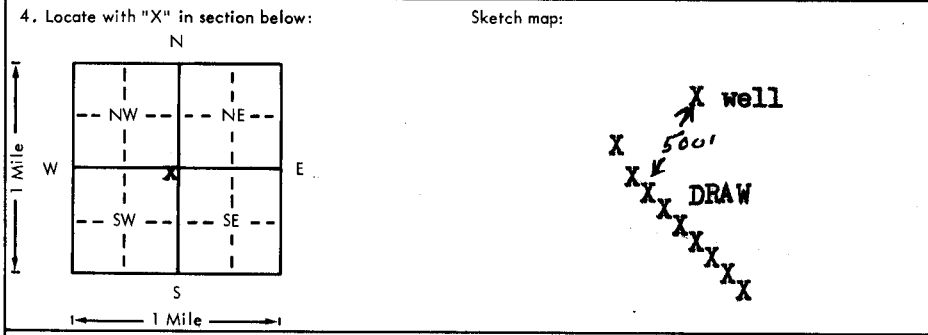

6. Bore hole dia. 9 in. Completion date 3-6-1978
Well depth 195 ft.
7. Cable tool Rotary Driven Dug
 Hollow rod Jetted Bored Reverse rotary
8. Use: Domestic Public supply Industry
 Irrigation Air conditioning Stock
 Lawn Oil field water Other
9. Casing: Material Plastic Height: Above or below
Threaded Welded Glue Surface 12 in.
RMP PVC Weight 1.8 lbs./ft.
Dia. 5 in. to 175 ft. depth Wall Thickness: inches or
Dia. in. to ft. depth Gage No. .250

5. Type and color of material	From	To
Clay	0	20
Gyp	20	40
Sand rock	40	42
Sandy clay	42	60
Sand coarse	60	70
Sandy clay	70	87
Sand coarse	87	102
Fine sand	102	110
Fine sand clay	110	120
Sand coarse	120	137
Fine sand clay	137	152
Sand coarse	152	166
Sand rock H	166	168
Sand coarse	168	176
Fine sand clay	176	180
Sand coarse	180	189
Clay sandy fine	189	192
Yellow	192	195

10. Screen: Manufacturer's name Jess & Lowell
Type RMP Dia. 5"
Slot/gauge 1/16" Length 20'
Set between 175 ft. and 195 ft.
Gravel pack? yes Size range of material 1/4x1/8"
11. Static water level: 122 ft. below land surface Date 3-6-1978 mo./day/yr.
12. Pumping level below land surfaces:
125 ft. after 1 hrs. pumping 4 g.p.m.
 ft. after hrs. pumping g.p.m.
Estimated maximum yield 4 g.p.m.
13. Water sample submitted: mo./day/yr.
 Yes No Date
14. Well head completion:
 Pitless adapter 12 Inches above grade
15. Well grouted? yes
With: Neat cement Bentonite Concrete
Depth: From 0 ft. to 15 ft.
16. Nearest source of possible contamination:
ft. 500 Direction S/W Type Draw
Well disinfected upon completion? yes Yes No
17. Pump:
 Not installed
Manufacturer's name Aermotor windmill
Model number HP Volts
Length of drop pipe 185 ft. capacity 4 g.p.m.
Type:
 Submersible Turbine
 Jet Reciprocating
 Centrifugal cylinder

18. Elevation: Topography: Hill Slope Upland Valley
19. Remarks: TOPO 5512

20. Water well contractor's certification:
This well was drilled under my jurisdiction and this report is true to the best of my knowledge and belief.
Weishaar Drilling & Sup. 232
Business name Weishaar Drilling & Sup. 232 License No.
Address Garden City, KS 67871
Signed [Signature] Date 3/7/78
Authorized representative

T 17 R 39 S 17 NE 1/4