USE TYPEWRITER OR BALL POINT PEN-PRESS FIRMLY, PRINT CLEARLY.

WATER WELL RECORD
KSA 82a-1201-1215

Kansas Department of Health and Environment-Division of Environment
(Water well Contractors)
Topeka, Kansas 66620

1. Location of well:	County	Fraction	Section number	Township number	Range number
	Greeley	N/W 1/4 S/W 1/4 S/E 1/4	18	T 17 S	R 39 E/W

2. Distance and direction from nearest town or city:
8 N 1/2 E of Whitelaw, Kansas
Street address of well location if in city:

3. Owner of well: B. W. Quance
R.R. or street: 345 S. High
City, state, zip code: Dighton, Kansas 67839

4. Locate with "X" in section below:

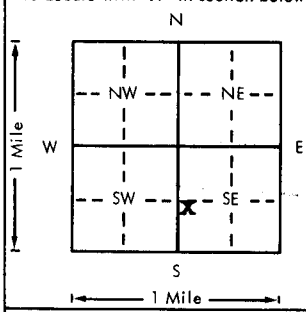

Sketch map:

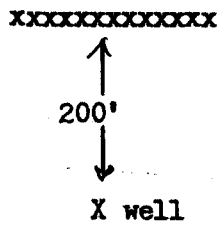

6. Bore hole dia. 9 in. Completion date
Well depth 180 ft. 4/4/1978

7. __ Cable tool X Rotary __ Driven __ Dug
__ Hollow rod __ Jetted __ Bored __ Reverse rotary

8. Use: __ Domestic __ Public supply __ Industry
__ Irrigation __ Air conditioning X Stock
__ Lawn __ Oil field water __ Other

9. Casing: Material Plastic Weight: Above or below
Threaded ___ Welded Glue Surface 12 in.
RMP X PVC ___ Weight 1.8 lbs./ft.
Dia. 5 in. to 160 ft. depth Wall Thickness: inches or
Dia. ___ in. to ___ ft. depth gage No. 250

5. Type and color of material	From	To
Clay	0	9
Rock H	9	12
Gyp	12	18
Clay	18	33
Gyp	33	38
Clay	38	40
Sand rock	40	42
Sand coarse	42	47
Clay	47	52
Sand coarse	52	80
Fine sand clay	80	96
Clay	96	110
Fine sand clay	110	124
Clay	124	135
Fine sand clay	135	140
Sand coarse	140	147
Clay	147	154
Sand coarse	154	158
Clay	158	162
Sand coarse	162	167
Clay	167	170
Sand coarse	170	174
Clay	174	175
Sand coarse	175	180
Clay yellow	180	
(Use a second sheet if needed)		

10. Screen: Manufacturer's name Jess & Lowell
Type RMP Dia. 5"
Slot/gauze 1/16" Length 20'
Set between 160 ft. and 180 ft.
___ ft. and ___ ft.
Gravel pack? yes Size range of material 1/4X1/8"

11. Static water level: mo./day/yr.
122 ft. below land surface Date 4/3/1978

12. Pumping level below land surfaces:
124 ft. after 1 hrs. pumping 4 g.p.m.
___ ft. after ___ hrs. pumping ___ g.p.m.
Estimated maximum yield 4 g.p.m.

13. Water sample submitted: mo./day/yr.
__ Yes X No Date

14. Well head completion:
__ Pitless adapter 12 Inches above grade

15. Well grouted? yes
With: X Neat cement __ Bentonite __ Concrete
Depth: From 0 ft. to 15 ft.

16. Nearest source of possible contamination:
ft. 200 Direction N Type draw
Well disinfected upon completion? X Yes __ No

17. Pump: __ Not installed
Manufacturer's name Aermotor mill
Model number ___ HP ___ Volts ___
Length of drop pipe 164 ft. capacity 4 g.p.m.
Type:
__ Submersible __ Turbine
__ Jet __ Reciprocating
__ Centrifugal cylinder Other

18. Elevation:
Topography:
__ Hill
X Slope
__ Upland
__ Valley

19. Remarks:

20. Water well contractor's certification:
This well was drilled under my jurisdiction and this report is true to the best of my knowledge and belief.
Weishaar Drilling & Sup. 232
Business name License No.
Address Scott City, Kansas 67871
Signed [signature] Date 4/18/78
Authorized representative

T 17 S R 39 E/W Sec 18 1/4 1/4 1/4 1/4 NW SE

Forward the white, blue and pink copies to the Department of Health and Environment

Form WWC-5