


McPherson

1 LOCATION OF WATER WELL: Fraction NW 1/4 NE 1/4 NE 1/4 Section Number 35 Township Number T 17 S Range Number R 4 E/W

Distance and direction from nearest town or city street address of well if located within city? 2 miles West and 2 miles South of Lindsborg, KS

2 WATER WELL OWNER: Carl Hershberger RR#, St. Address, Box #: 204 W. McPherson City, State, ZIP Code: Lindsborg, KS 67456

3 LOCATE WELL'S LOCATION WITH AN "X" IN SECTION BOX:

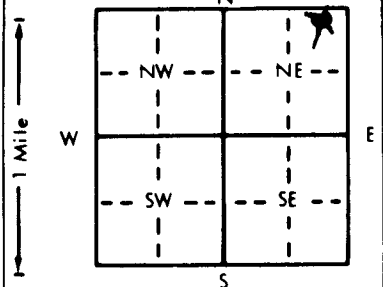

4 DEPTH OF COMPLETED WELL: 60 ft. ELEVATION: ... WELL'S STATIC WATER LEVEL: 27 ft. below land surface measured on mo/day/yr 7-12-96. Pump test data: Well water was ... Est. Yield: 20 gpm. Bore Hole Diameter: 8 in. to ... WELL WATER TO BE USED AS: 5 Public water supply, 8 Air conditioning, 11 Injection well, 1 Domestic, 3 Feedlot, 6 Oil field water supply, 9 Dewatering, 12 Other (Specify below), 2 Irrigation, 4 Industrial, X Lawn and garden only, 10 Monitoring well. Was a chemical/bacteriological sample submitted to Department? Yes No X; If yes, mo/day/yr sample was submitted Water Well Disinfected? Yes X No

5 TYPE OF BLANK CASING USED: 1 Steel, 3 RMP (SR), X PVC, 4 ABS, 5 Wrought iron, 6 Asbestos-Cement, 7 Fiberglass, 8 Concrete tile, 9 Other (specify below), CASING JOINTS: Glued X, Clamped, Welded, Threaded.

Blank casing diameter: 5 in. to 50 ft., Dia. in. to ft., Dia. in. to ft. Casing height above land surface: 12 in., weight lbs./ft. Wall thickness or gauge No.

TYPE OF SCREEN OR PERFORATION MATERIAL: 1 Steel, 2 Brass, 3 Stainless steel, 4 Galvanized steel, 5 Fiberglass, 6 Concrete tile, X PVC, 8 RMP (SR), 9 ABS, 10 Asbestos-cement, 11 Other (specify), 12 None used (open hole)

SCREEN OR PERFORATION OPENINGS ARE: 1 Continuous slot, 2 Louvered shutter, 3 Mill slot, 4 Key punched, 5 Gauzed wrapped, 6 Wire wrapped, 7 Torch cut, 8 Saw cut, 9 Drilled holes, 10 Other (specify), 11 None (open hole)

SCREEN-PERFORATED INTERVALS: From 50 ft. to 60 ft. GRAVEL PACK INTERVALS: From 20 ft. to 60 ft.

6 GROUT MATERIAL: 1 Neat cement, 2 Cement grout, X Bentonite, 4 Other. Grout Intervals: From 0 ft. to 20 ft.

What is the nearest source of possible contamination: 1 Septic tank, 2 Sewer lines, 3 Watertight sewer lines, 4 Lateral lines, 5 Cess pool, 6 Seepage pit, 7 Pit privy, 8 Sewage lagoon, 9 Feedyard, 10 Livestock pens, 11 Fuel storage, 12 Fertilizer storage, 13 Insecticide storage, 14 Abandoned water well, 15 Oil well/Gas well, 16 Other (specify below)

Direction from well? East How many feet? 200

Table with columns: FROM, TO, LITHOLOGIC LOG, FROM, TO, PLUGGING INTERVALS. Rows: 0-2 Top Soil, 2-45 Gray Clay, 45-60 Fine to Medium Sand, 60 Green Shale.

7 CONTRACTOR'S OR LANDOWNER'S CERTIFICATION: This water well was X) constructed, (2) reconstructed, or (3) plugged under my jurisdiction and was completed on (mo/day/year) 7/12/96 and this record is true to the best of my knowledge and belief. Kansas Water Well Contractor's License No. 138 This Water Well Record was completed on (mo/day/yr) 7/16/96 under the business name of Peterson Irrigation, Inc. by (signature) Mike Peterson