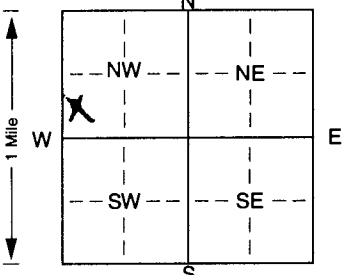


1 LOCATION OF WATER WELL: Fraction	Section Number	Township Number	Range Number
County: McPherson SW ¼ SW ¼ NW ¼	35	T 17 S	R 4 EW

Distance and direction from nearest town or city street address of well if located within city?
3 miles West & 2 1/2 Miles South of Lindsborg, KS

2 WATER WELL OWNER: **Tom Toll**
 RR#, St. Address, Box #: **2453 10th Ave.** Board of Agriculture, Division of Water Resources
 City, State, ZIP Code: **Lindsborg, KS 67456** Application Number: **45,036**

3 LOCATE WELL'S LOCATION WITH AN "X" IN SECTION BOX: 	4 DEPTH OF COMPLETED WELL: 61 ft. ELEVATION:
	Depth(s) Groundwater Encountered 1. ft. 2. ft. 3. ft. WELL'S STATIC WATER LEVEL 35 ft. below land surface measured on mo/day/yr 7/17/02 Pump test data: Well water was ft. after hours pumping gpm Est. Yield 300-500 gpm: Well water was ft. after hours pumping gpm Bore Hole Diameter: 30 in. to 61 ft., and in. to ft. WELL WATER TO BE USED AS: 5 Public water supply 8 Air conditioning 11 Injection well 1 Domestic 3 Feedlot 6 Oil field water supply 9 Dewatering 12 Other (Specify below) <input checked="" type="checkbox"/> Irrigation 4 Industrial 7 Domestic (lawn & garden) 10 Monitoring well Was a chemical/bacteriological sample submitted to Department? Yes. No. <input checked="" type="checkbox"/> ; If yes, mo/day/yr sample was submitted Water Well Disinfected? Yes <input checked="" type="checkbox"/> No

5 TYPE OF BLANK CASING USED: 5 Wrought iron 8 Concrete tile CASING JOINTS: Glued. Clamped.
 1 Steel 3 RMP (SR) 6 Asbestos-Cement 9 Other (specify below) Welded
 PVC 4 ABS 7 Fiberglass Threaded.....
 Blank casing diameter **12** in. to **41** ft., Dia in. to ft., Dia in. to ft.
 Casing height above land surface **12** in., weight **12.52** lbs./ft. Wall thickness or gauge No. **.490**
 TYPE OF SCREEN OR PERFORATION MATERIAL: PVC 10 Asbestos-cement
 1 Steel 3 Stainless steel 5 Fiberglass 8 RMP (SR) 11 Other (specify)
 2 Brass 4 Galvanized steel 6 Concrete tile 9 ABS 12 None used (open hole)
 SCREEN OR PERFORATION OPENINGS ARE: 5 Gauzed wrapped 8 Saw cut 11 None (open hole)
 1 Continuous slot Mill slot 6 Wire wrapped 9 Drilled holes
 2 Louvered shutter 4 Key punched 7 Torch cut 10 Other (specify) ft.
 SCREEN-PERFORATED INTERVALS: From **41** ft. to **61** ft., From ft. to ft.
 GRAVEL PACK INTERVALS: From **22** ft. to **61** ft., From ft. to ft.

6 GROUT MATERIAL: 1 Neat cement Cement grout 3 Bentonite 4 Other
 Grout intervals: From **0** ft. to **22** ft., From ft. to ft.
 What is the nearest source of possible contamination: Livestock pens 14 Abandoned water well
 1 Septic tank 4 Lateral lines 7 Pit privy 11 Fuel storage 15 Oil well/Gas well
 2 Sewer lines 5 Cess pool 8 Sewage lagoon 12 Fertilizer storage 16 Other (specify below)
 3 Watertight sewer lines 6 Seepage pit 9 Feedyard 13 Insecticide storage
 Direction from well? **West** How many feet? **200**

FROM	TO	LITHOLOGIC LOG	FROM	TO	PLUGGING INTERVALS
0	2	Topsoil			
2	27	Clay, tan			
27	61	Sand, medium			
	61	Shale, green			

7 CONTRACTOR'S OR LANDOWNER'S CERTIFICATION: This water well was (constructed, (2) reconstructed, or (3) plugged under my jurisdiction and was completed on (mo/day/year) **7/17/02** and this record is true to the best of my knowledge and belief. Kansas Water Well Contractor's Licence No. **138** This Water Well Record was completed on (mo/day/yr), **7/29/02** under the business name of **Peterson Irrigation, Inc.** by (signature) *Mike Peterson*