

WATER WELL RECORD

Form WWC-5

Division of Water Resources App. No.


Empty box for application number

1 LOCATION OF WATER WELL: County: McPherson, Fraction: 1/4 NW 1/4 SW 1/4 SW 1/4, Section Number: 31, Township No.: T 17 S, Range Number: R 4

Street/Rural Address of Well Location; if unknown, distance & direction from nearest town or intersection: 2 miles South & 1 mile East of Marquette

2 WATER WELL OWNER: Terry Hopp, RR#, Street Address, Box #: 2412 7th Ave., City, State, ZIP Code: Marquette, KS 67464

Global Positioning System (GPS) information: Latitude, Longitude, Elevation, Datum, Collection Method

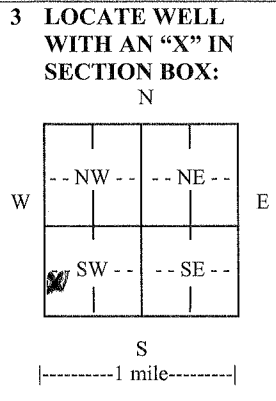

4 DEPTH OF COMPLETED WELL 58 ft. Depth(s) Groundwater Encountered, WELL'S STATIC WATER LEVEL 33 ft., Pump test data, EST. YIELD, Bore Hole Diameter, WELL WATER TO BE USED AS, Was a chemical/bacteriological sample submitted, Water well disinfected?

5 TYPE OF CASING USED: Steel, PVC, Other. CASING JOINTS: Glued, Clamped, Welded, Threaded. TYPE OF SCREEN OR PERFORATION MATERIAL: Steel, Stainless Steel, PVC, Brass, Galvanized Steel, None used. SCREEN OR PERFORATION OPENINGS ARE: Continuous slot, Mill slot, Gauze wrapped, Torch cut, Drilled holes, Louvered shutter, Key punched, Wire wrapped, Saw cut, Other. SCREEN-PERFORATED INTERVALS, GRAVEL PACK INTERVALS

6 GROUT MATERIAL: Neat cement, Cement grout, Bentonite, Other. Grout Intervals, What is the nearest source of possible contamination: Septic tank, Lateral lines, Pit privy, Livestock pens, Insecticide storage, Sewer lines, Cesspool, Sewage lagoon, Fuel storage, Abandoned water well, Watertight sewer lines, Seepage pit, Feedyard, Fertilizer storage, Oil well/gas well. Direction from well: South, Distance from well: 100 ft.

Table with columns: FROM, TO, LITHOLOGIC LOG, FROM, TO, LITHO. LOG (cont.) or PLUGGING INTERVALS. Rows: 0-2 Topsoil, 2-35 Clay, gray, 35-40 Sandy gray clay, 40-60 Sand, fine to medium

7 CONTRACTOR'S OR LANDOWNER'S CERTIFICATION: This water well was constructed, reconstructed, or plugged under my jurisdiction and was completed on (mo/day/year) 5/19/11 and this record is true to the best of my knowledge and belief. Kansas Water Well Contractor's License No. 138. This Water Well Record was completed on (mo/day/year) 5/26/11 under the business name of Peterson Irrigation, Inc. by (signature) Michael Peterson

INSTRUCTIONS: Use typewriter or ball point pen. PLEASE PRESS FIRMLY and PRINT clearly. Please fill in blanks and check the correct answers. Send three copies (white, blue, pink) to Kansas Department of Health and Environment, Bureau of Water, Geology Section, 1000 SW Jackson St., Suite 420, Topeka, Kansas 66612-1367. Telephone 785-296-5522. Send one copy to WATER WELL OWNER and retain one for your records. Include fee of \$5.00 for each constructed well. Visit us at http://www.kdheks.gov/waterwell/index.html.