


1 LOCATION OF WATER WELL: County: Greely Fraction: SE 1/4 SE 1/4 SE 1/4 Section Number: 6 Township Number: T 17 S Range Number: R 90 EW

Distance and direction from nearest town or city street address of well if located within city?

2 WATER WELL OWNER: Ervin Schneider
 RR#, St. Address, Box #: Box 86 City, State, ZIP Code: Tribune 67879
 Board of Agriculture, Division of Water Resources
 Application Number:

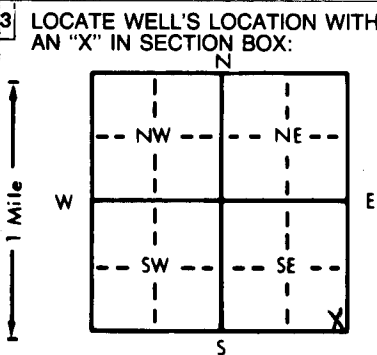

4 DEPTH OF COMPLETED WELL: 180 ft. ELEVATION:
 Depth(s) Groundwater Encountered 1. 168 ft. 2. ft. 3. ft.
 WELL'S STATIC WATER LEVEL: 168 ft. below land surface measured on mo/day/yr 10-6-90
 Pump test data: Well water was 178 ft. after 1 hours pumping 8 gpm
 Est. Yield 8 gpm: Well water was ft. after hours pumping gpm
 Bore Hole Diameter: 6" in. to 180 ft., and in. to ft.
 WELL WATER TO BE USED AS:
 1 Domestic 3 Feedlot 6 Oil field water supply 9 Dewatering 12 Other (Specify below)
 2 Irrigation 4 Industrial 7 Lawn and garden only 10 Monitoring well
 Was a chemical/bacteriological sample submitted to Department? Yes.....No.....X; If yes, mo/day/yr sample was submitted
 Water Well Disinfected? Yes X No

5 TYPE OF BLANK CASING USED:
 1 Steel 3 RMP (SR) 5 Wrought iron 8 Concrete tile CASING JOINTS: Glued X Clamped
 2 PVC 4 ABS 6 Asbestos-Cement 9 Other (specify below) Welded
 7 Fiberglass Threaded
 Blank casing diameter 5 in. to 160 ft., Dia in. to ft., Dia in. to ft.
 Casing height above land surface 21 in., weight 281 lbs./ft. Wall thickness or gauge No. 265
 TYPE OF SCREEN OR PERFORATION MATERIAL:
 1 Steel 3 Stainless steel 5 Fiberglass 8 RMP (SR) 10 Asbestos-cement 11 Other (specify)
 2 Brass 4 Galvanized steel 6 Concrete tile 9 ABS 12 None used (open hole)
 SCREEN OR PERFORATION OPENINGS ARE:
 1 Continuous slot 3 Mill slot 5 Gauzed wrapped 8 Saw cut 11 None (open hole)
 2 Louvered shutter 4 Key punched 6 Wire wrapped 9 Drilled holes
 7 Torch cut 10 Other (specify)
 SCREEN-PERFORATED INTERVALS: From 160 ft. to 180 ft., From ft. to ft.
 From ft. to ft., From ft. to ft.
 GRAVEL PACK INTERVALS: From 20 ft. to 160 ft., From ft. to ft.
 From ft. to ft., From ft. to ft.

6 GROUT MATERIAL: Neat cement 2 Cement grout 3 Bentonite 4 Other
 Grout Intervals: From 0 ft. to 20 ft., From ft. to ft., From ft. to ft.
 What is the nearest source of possible contamination:
 1 Septic tank 4 Lateral lines 7 Pit privy 10 Livestock pens 14 Abandoned water well
 2 Sewer lines 5 Cess pool 8 Sewage lagoon 11 Fuel storage 15 Oil well/Gas well
 3 Watertight sewer lines 6 Seepage pit 9 Feedyard 12 Fertilizer storage 16 Other (specify below)
 13 Insecticide storage pasture well
 Direction from well? 1 mile north How many feet? 5280

| FROM | TO | LITHOLOGIC LOG | FROM | TO | PLUGGING INTERVALS |
|------|-----|-------------------------|------|----|--------------------|
| 0 | 60 | clay | | | |
| 60 | 70 | sand | | | |
| 70 | 85 | sandy clay | | | |
| 85 | 105 | sand & sand clay strips | | | |
| 105 | 130 | sand | | | |
| 130 | 150 | sand + sandy clay | | | |
| 150 | 170 | sand | | | |
| 170 | 177 | yellow clay | | | |
| 177 | 180 | blue shale | | | |

7 CONTRACTOR'S OR LANDOWNER'S CERTIFICATION: This water well was (1) constructed, (2) reconstructed, or (3) plugged under my jurisdiction and was completed on (mo/day/year) 10-6-90 and this record is true to the best of my knowledge and belief. Kansas Water Well Contractor's License No. 213 This Water Well Record was completed on (mo/day/yr) 10-20-90 under the business name of Kemp's Well Service by (signature) [Signature]

OFFICE USE ONLY
T
R
EW
SEC
1/4
1/4
1/4