


1 LOCATION OF WATER WELL: County: <u>Greeley</u>	Fraction <u>SW 1/4 NW 1/4 NW 1/4</u>	Section Number <u>13</u>	Township Number <u>T 17 S</u>	Range Number <u>R 40 E/W</u>
---	---	-----------------------------	----------------------------------	---------------------------------

Distance and direction from nearest town or city street address of well if located within city?
800' South and 600' East of the NW Corner.

2 WATER WELL OWNER: Calvin Doty
 RR#, St. Address, Box #: Rural Route
 City, State, ZIP Code: Tribune, Ks. 67879
 Board of Agriculture, Division of Water Resources
 Application Number:

3 LOCATE WELL'S LOCATION WITH AN "X" IN SECTION BOX:

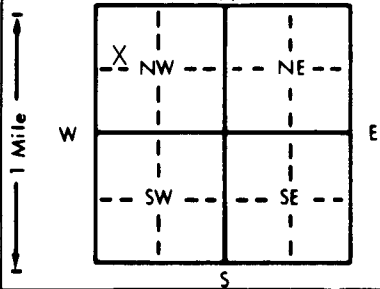

4 DEPTH OF COMPLETED WELL... 190' ft. ELEVATION: ft.
 Depth(s) Groundwater Encountered 1.135' ft. 2. ft. 3. ft.
 WELL'S STATIC WATER LEVEL 135' ft. below land surface measured on mo/day/yr ft.
 Pump test data: Well water was 160 ft. after 3 hours pumping 20 gpm
 Est. Yield gpm: Well water was ft. after hours pumping gpm
 Bore Hole Diameter... 12" in. to ft., and in. to ft.
 WELL WATER TO BE USED AS:
 Domestic 3 Feedlot 6 Oil field water supply 9 Dewatering 12 Other (Specify below)
 Irrigation 4 Industrial 7 Lawn and garden only 10 Monitoring well
 Was a chemical/bacteriological sample submitted to Department? Yes.....No........; If yes, mo/day/yr sample was submitted
 Water Well Disinfected? Yes No

5 TYPE OF BLANK CASING USED:
 1 Steel 3 RMP (SR) 5 Wrought iron 8 Concrete tile CASING JOINTS: Glued Clamped
 PVC 4 ABS 6 Asbestos-Cement 9 Other (specify below) Welded
 Threaded.....
 Blank casing diameter ... 5" in. to 150' ft., Dia in. to ft., Dia in. to ft.
 Casing height above land surface... 24" in., weight lbs./ft. Wall thickness or gauge No.

TYPE OF SCREEN OR PERFORATION MATERIAL:
 1 Steel 3 Stainless steel 5 Fiberglass PVC 10 Asbestos-cement
 2 Brass 4 Galvanized steel 6 Concrete tile 8 RMP (SR) 11 Other (specify)
 12 None used (open hole)
 SCREEN OR PERFORATION OPENINGS ARE:
 1 Continuous slot 3 Mill slot 5 Gauzed wrapped Saw cut 11 None (open hole)
 2 Louvered shutter 4 Key punched 6 Wire wrapped 9 Drilled holes
 7 Torch cut 10 Other (specify)

SCREEN-PERFORATED INTERVALS: From... 150' ft. to ... 190' ft., From ft. to ft.
 From ft. to ft., From ft. to ft.
 GRAVEL PACK INTERVALS: From... 20' ft. to ... 190' ft., From ft. to ft.
 From ft. to ft., From ft. to ft.

6 GROUT MATERIAL: 1 Neat cement 2 Cement grout Bentonite 4 Other
 Grout Intervals: From... 0 ft. to ... 20' ft., From ft. to ft., From ft. to ft.
 What is the nearest source of possible contamination:
 1 Septic tank 4 Lateral lines 7 Pit privy 10 Livestock pens 14 Abandoned water well
 2 Sewer lines 5 Cess pool 8 Sewage lagoon 11 Fuel storage 15 Oil well/Gas well
 3 Watertight sewer lines 6 Seepage pit 9 Feedyard 12 Fertilizer storage Other (specify below)
 13 Insecticide storage ... Unknown
 Direction from well? How many feet?

FROM	TO	LITHOLOGIC LOG	FROM	TO	PLUGGING INTERVALS
0	3	Top Soil			
3	15	Sandy Clay			
15	41	Caliche			
41	77	Coarse Sand, Small Gravel Cemented			
77	95	Clay			
95	108	Coarse Sand			
108	111	Clay			
111	117	Coarse Sand, Small to Medium Gravel			
117	135	Fine Sand			
135	182	Coarse Sand, Small Gravel Loose			
182	200	Yellow Clay, Blue Shale			
	200	Total Depth			

7 CONTRACTOR'S OR LANDOWNER'S CERTIFICATION: This water well was constructed, (2) reconstructed, or (3) plugged under my jurisdiction and was completed on (mo/day/year) ... 11/06/92 and this record is true to the best of my knowledge and belief. Kansas Water Well Contractor's License No. 514 This Water Well Record was completed on (mo/day/yr) ... 11/27/92 under the business name of Miller Gearhead & Pump Repair Inc. by (signature) Everett Miller

INSTRUCTIONS: Use typewriter or ball point pen. PLEASE PRESS FIRMLY and PRINT clearly. Please fill in blanks, underline or circle the correct answers. Send top three copies to Kansas Department of Health and Environment, Bureau of Water, Topeka, Kansas 66620-0001. Telephone: 913-296-5545. Send one to WATER WELL OWNER and retain one for your records.