


WATER WELL RECORD Form WWC-5 KSA 82a-1212

1 LOCATION OF WATER WELL: County: <u>Greeley</u>	Fraction <u>NE 1/4 NW 1/4 NW 1/4</u>	Section Number <u>17</u>	Township Number <u>T 17 S</u>	Range Number <u>R X 40 W</u>
-----------------------------------------------------	-----------------------------------------	-----------------------------	----------------------------------	---------------------------------

Distance and direction from nearest town or city street address of well if located within city?
8 miles north, 1 1/2 west of Tribune, KS 67879

2 WATER WELL OWNER: Darwin Hoffamn
 RR#, St. Address, Box # : Star Route
 City, State, ZIP Code : Tribune, KS 67879
 Board of Agriculture, Division of Water Resources
 Application Number: 11209

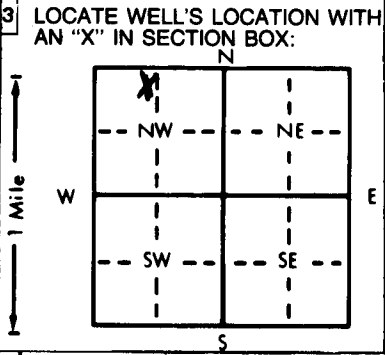

4 DEPTH OF COMPLETED WELL: 223 ft. ELEVATION: 3640
 Depth(s) Groundwater Encountered 185 ft. 2. ft. 3. ft.
 WELL'S STATIC WATER LEVEL 185 ft. below land surface measured on 7-1-91
 Pump test data: Well water was 220 ft. after 6 hours pumping 140 gpm
 Est. Yield 140 gpm: Well water was ft. after hours pumping gpm
 Bore Hole Diameter: 26 in. to ft., and in. to ft.
 WELL WATER TO BE USED AS:
 1 Domestic 2 Irrigation 3 Feedlot 4 Industrial 5 Public water supply 6 Oil field water supply 7 Lawn and garden only 8 Air conditioning 9 Dewatering 10 Monitoring well 11 Injection well 12 Other (Specify below)
 Was a chemical/bacteriological sample submitted to Department? Yes.....No. X.....; If yes, mo/day/yr sample was sub-
 mitted Water Well Disinfected? Yes X No

5 TYPE OF BLANK CASING USED:
 1 Steel 2 PVC 3 RMP (SR) 4 ABS 5 Wrought iron 6 Asbestos-Cement 7 Fiberglass 8 Concrete tile 9 Other (specify below) CASING JOINTS: Glued X Clamped Welded Threaded
 Blank casing diameter 12 in. to 183 ft., Dia. in. to ft., Dia. in. to ft.
 Casing height above land surface 12 in., weight lbs./ft. Wall thickness or gauge No. Sch 40
 TYPE OF SCREEN OR PERFORATION MATERIAL:
 1 Steel 2 Brass 3 Stainless steel 4 Galvanized steel 5 Fiberglass 6 Concrete tile 7 PVC 8 RMP (SR) 9 ABS 10 Asbestos-cement 11 Other (specify) 12 None used (open hole)
 SCREEN OR PERFORATION OPENINGS ARE:
 1 Continuous slot 2 Louvered shutter 3 Mill slot 4 Key punched 5 Gauzed wrapped 6 Wire wrapped 7 Torch cut 8 Saw cut 9 Drilled holes 11 None (open hole)
 SCREEN-PERFORATED INTERVALS: From 183 ft. to 223 ft., From ft. to ft.
 GRAVEL PACK INTERVALS: From 22 ft. to 223 ft., From ft. to ft.

6 GROUT MATERIAL: 1 Neat cement 2 Cement grout 3 Bentonite 4 Other
 Grout intervals: From 0 ft. to 22 ft., From ft. to ft., From ft. to ft.
 What is the nearest source of possible contamination:
 1 Septic tank 2 Sewer lines 3 Watertight sewer lines 4 Lateral lines 5 Cess pool 6 Seepage pit 7 Pit privy 8 Sewage lagoon 9 Feedyard 10 Livestock pens 11 Fuel storage 12 Fertilizer storage 13 Insecticide storage 14 Abandoned water well 15 Oil well/Gas well 16 Other (specify below)
 Direction from well? West How many feet? 120

FROM	TO	LITHOLOGIC LOG	FROM	TO	PLUGGING INTERVALS
0	16	top soil & limestone			
16	82	limestone & little sand			
82	99	sand & little clay			
99	132	sandy clay & little limestone			
132	148	cemented sand & little limestone			
148	165	sand (medium) & 4' clay			
165	195	sand (medium)			
195	198	clay & 1' sand			
198	214	sand (medium) dirty & 3' clay			
214	223	yellow clay			
218	223	shale			

7 CONTRACTOR'S OR LANDOWNER'S CERTIFICATION: This water well was (1) constructed, (2) reconstructed, or (3) plugged under my jurisdiction and was completed on (mo/day/year) XXXX 7-2-91 and this record is true to the best of my knowledge and belief. Kansas Water Well Contractor's License No. 473 This Water Well Record was completed on (mo/day/yr) 7-24-91 under the business name of Tyler Water Well Service by (signature) Tyler Eyles

INSTRUCTIONS: Use typewriter or ball point pen. PLEASE PRESS FIRMLY and PRINT clearly. Please fill in blanks, underline or circle the correct answers. Send top three copies to Kansas Department of Health and Environment, Bureau of Water Protection, Topeka, Kansas 66620-7320. Telephone: 913-296-5514. Send one to WATER WELL OWNER and retain one for your records.