


1 LOCATION OF WATER WELL: County: Greeley Fraction: SW 1/4 SW 1/4 SE 1/4 Section Number: 26 Township Number: T 17 S Range Number: R 40 EW

Distance and direction from nearest town or city street address of well if located within city?
5 N - 2 1/2 E of Tribune

2 WATER WELL OWNER: Howard Gibson
 RR#, St. Address, Box # :
 City, State, ZIP Code : Tribune, Kans. 67879
 Board of Agriculture, Division of Water Resources
 Application Number:

3 LOCATE WELL'S LOCATION WITH AN "X" IN SECTION BOX:

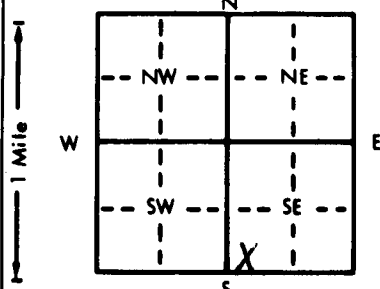

4 DEPTH OF COMPLETED WELL: 183 ft. ELEVATION: 3620

Depth(s) Groundwater Encountered 1. 141 ft. 2. ft. 3. ft.
 WELL'S STATIC WATER LEVEL 141 ft. below land surface measured on mo/day/yr 5-23-86
 Pump test data: Well water was 160 ft. after 3 hours pumping 20 gpm
 Est. Yield 40 gpm: Well water was ft. after hours pumping gpm
 Bore Hole Diameter 8 in. to 60 ft., and 6 1/2 in. to 183 ft.
 WELL WATER TO BE USED AS:
 1 Steel 3 RMP (SR) 5 Public water supply 8 Air conditioning 11 Injection well
 2 PVC 4 ABS 6 Oil field water supply 9 Dewatering 12 Other (Specify below)
 2 Irrigation 4 Industrial 7 Lawn and garden only 10 Observation well
 Was a chemical/bacteriological sample submitted to Department? Yes.....No.....; If yes, mo/day/yr sample was submitted
 Water Well Disinfected? Yes No

5 TYPE OF BLANK CASING USED:
 1 Steel 3 RMP (SR) 5 Wrought iron 8 Concrete tile CASING JOINTS: Glued Clamped
 2 PVC 4 ABS 6 Asbestos-Cement 9 Other (specify below) Welded X
 7 Fiberglass Threaded

Blank casing diameter 5 in. to 143 ft., Dia. in. to ft., Dia. in. to ft.
 Casing height above land surface 18 in., weight 10.5 lbs./ft. Wall thickness or gauge No. 219

TYPE OF SCREEN OR PERFORATION MATERIAL:
 1 Steel 3 Stainless steel 5 Fiberglass 8 RMP (SR) 11 Other (specify)
 2 Brass 4 Galvanized steel 6 Concrete tile 9 ABS 12 None used (open hole)

SCREEN OR PERFORATION OPENINGS ARE:
 1 Continuous slot 3 Mill slot 5 Gauzed wrapped 8 Saw cut 11 None (open hole)
 2 Louvered shutter 4 Key punched 6 Wire wrapped 9 Drilled holes
 7 Torch cut 10 Other (specify)

SCREEN-PERFORATED INTERVALS: From 143 ft. to 183 ft., From ft. to ft.
 GRAVEL PACK INTERVALS: From 120 ft. to 183 ft., From ft. to ft.

6 GROUT MATERIAL: 1 Neat cement 2 Cement grout 3 Bentonite 4 Other
 Grout intervals: From 6 ft. to 26 ft., From ft. to ft., From ft. to ft.

What is the nearest source of possible contamination:
 1 Septic tank 4 Lateral lines 7 Pit privy 10 Livestock pens 14 Abandoned water well
 2 Sewer lines 5 Cess pool 8 Sewage lagoon 11 Fuel storage 15 Oil well/Gas well
 3 Watertight sewer lines 6 Seepage pit 9 Feedyard 12 Fertilizer storage 16 Other (specify below)
 13 Insecticide storage

Direction from well? How many feet?

FROM	TO	LITHOLOGIC LOG	FROM	TO	LITHOLOGIC LOG
0	30	Top soil	191	195	Clay & Lime
30	67	Lime & clay (very hard)	195	204	clay
67	75	clay	204		Shale
75	90	clay & Lime			
90	96	Sandy clay			
96	135	clay & Lime			
135	136	Sand			
136	144	clay			
144	150	Sandy clay			
150	152	Sand			
152	159	clay			
159	165	clay & fine sand			
165	180	Sand & 2' clay			
180	182	Sand			
182	191	clay			

7 CONTRACTOR'S OR LANDOWNER'S CERTIFICATION: This water well was (1) constructed, (2) reconstructed, or (3) plugged under my jurisdiction and was completed on (mo/day/year) 5-23-86 and this record is true to the best of my knowledge and belief. Kansas Water Well Contractor's License No. 473 This Water Well Record was completed on (mo/day/yr) 5-23-86 under the business name of Tyler Water Well by (signature) Paul E. [Signature]