


1 LOCATION OF WATER WELL: County: Greely Fraction: N 1/4 NE 1/4 SW 1/4 Section Number: 29 Township Number: T 17 S Range Number: R 41 E/W

Distance and direction from nearest town or city street address of well if located within city? 7 mile N W of Tribune

2 WATER WELL OWNER: Richard Wendelberg
 RR#, St. Address, Box #: RR 1 Box 104
 City, State, ZIP Code: Tribune Kansas 67879
 Board of Agriculture, Division of Water Resources
 Application Number:

3 LOCATE WELL'S LOCATION WITH AN "X" IN SECTION BOX:

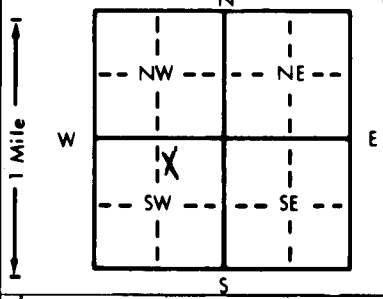

4 DEPTH OF COMPLETED WELL: 79 ft. ELEVATION:

Depth(s) Groundwater Encountered 1. ft. 2. ft. 3. ft.
 WELL'S STATIC WATER LEVEL 5.3 ft. below land surface measured on mo/day/yr
 Pump test data: Well water was 7.0 ft. after 1 hours pumping 2 gpm
 Est. Yield 2 gpm: Well water was ft. after hours pumping gpm
 Bore Hole Diameter 8" in. to 79 ft., and in. to ft.
 WELL WATER TO BE USED AS:
 5 Public water supply 8 Air conditioning 11 Injection well
1 Domestic 3 Feedlot 6 Oil field water supply 9 Dewatering 12 Other (Specify below)
 2 Irrigation 4 Industrial 7 Lawn and garden only 10 Monitoring well
 Was a chemical/bacteriological sample submitted to Department? Yes. No. X; If yes, mo/day/yr sample was submitted
 Water Well Disinfected? Yes X No

5 TYPE OF BLANK CASING USED:
 1 Steel 3 RMP (SR) 5 Wrought iron 8 Concrete tile CASING JOINTS: Glued X Clamped
2 PVC 4 ABS 7 Fiberglass Welded
 Blank casing diameter 5.3 in. to 5.3 ft., Dia. in. to ft., Dia. in. to ft.
 Casing height above land surface 1 in., weight 2.81 lbs./ft. Wall thickness or gauge No. 2.65

TYPE OF SCREEN OR PERFORATION MATERIAL:
 1 Steel 3 Stainless steel 5 Fiberglass 8 RMP (SR) 11 Other (specify)
 2 Brass 4 Galvanized steel 6 Concrete tile 9 ABS 12 None used (open hole)
 SCREEN OR PERFORATION OPENINGS ARE:
 1 Continuous slot 3 Mill slot 5 Gauzed wrapped 8 Saw cut 11 None (open hole)
 2 Louvered shutter 4 Key punched 7 Torch cut 9 Drilled holes
 SCREEN-PERFORATED INTERVALS: From 5.3 ft. to 7.3 ft., From ft. to ft.
 From ft. to ft., From ft. to ft.
 GRAVEL PACK INTERVALS: From 2.0 ft. to 7.3 ft., From ft. to ft.
 From ft. to ft., From ft. to ft.

6 GROUT MATERIAL: Neat cement 2 Cement grout 3 Bentonite 4 Other
 Grout Intervals: From 0 ft. to 2.0 ft., From ft. to ft., From ft. to ft.
 What is the nearest source of possible contamination:
 1 Septic tank 4 Lateral lines 7 Pit privy 11 Fuel storage 14 Abandoned water well
 2 Sewer lines 5 Cess pool 8 Sewage lagoon 12 Fertilizer storage 15 Oil well/Gas well
 3 Watertight sewer lines 6 Seepage pit 9 Feedyard 13 Insecticide storage 16 Other (specify below)
 Direction from well? North West How many feet? 2500

FROM	TO	LITHOLOGIC LOG	FROM	TO	PLUGGING INTERVALS
0	40	sand & clay strips			
40	45	sand Rock			
45	58	sand			
58	68	yellow clay			
68	73	blue shale			

7 CONTRACTOR'S OR LANDOWNER'S CERTIFICATION: This water well was (1) constructed, (2) reconstructed, or (3) plugged under my jurisdiction and was completed on (mo/day/year) 9-26-90 and this record is true to the best of my knowledge and belief. Kansas Water Well Contractor's License No. 213 This Water Well Record was completed on (mo/day/yr) 10-20-96 under the business name of Hemp's Well Service by (signature) George Kemp