


1 LOCATION OF WATER WELL: Fraction SE 1/4 SW 1/4 SW 1/4 Section Number 8 Township Number T 17 S Range Number R 41 E/W
 County: Greeley

Distance and direction from nearest town or city street address of well if located within city?
 8 N W 6 3/4

2 WATER WELL OWNER: Mark Robertson
 RR#, St. Address, Box #: Tribune, Kans. 67879
 City, State, ZIP Code: Board of Agriculture, Division of Water Resources
 Application Number:

3 LOCATE WELL'S LOCATION WITH AN "X" IN SECTION BOX:

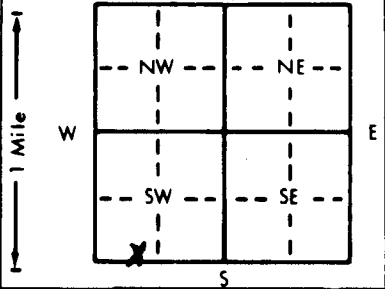

4 DEPTH OF COMPLETED WELL... 134 ft. ELEVATION: 3620 ft.
 Depth(s) Groundwater Encountered 1... 114 ft. 2... ft. 3... ft.
 WELL'S STATIC WATER LEVEL . 114 ft. below land surface measured on mo/day/yr
 Pump test data: Well water was . 116 ft. after . 2 hours pumping . 7 gpm
 Est. Yield . 10 gpm: Well water was . ft. after . hours pumping . gpm
 Bore Hole Diameter . 9 3/4 in. to . 134 ft., and . in. to . ft.
 WELL WATER TO BE USED AS: 5 Public water supply 8 Air conditioning 11 Injection well
 X1 Domestic 3 Feedlot 6 Oil field water supply 9 Dewatering 12 Other (Specify below)
 2 Irrigation 4 Industrial 7 Lawn and garden only 10 Monitoring well
 Was a chemical/bacteriological sample submitted to Department? Yes.....No..X.....; If yes, mo/day/yr sample was submitted Water Well Disinfected? Yes X No

5 TYPE OF BLANK CASING USED: 5 Wrought iron 8 Concrete tile CASING JOINTS: Glued.....Clamped.....
 1 Steel 3 RMP (SR) 6 Asbestos-Cement 9 Other (specify below) Welded.....
 X 2 PVC 4 ABS 7 Fiberglass Threaded.....
 Blank casing diameter . 5 in. to . 114 ft., Dia . in. to . ft., Dia . in. to . ft.
 Casing height above land surface . 24 in., weight . lbs./ft. Wall thickness or gauge No. . SDR21
 TYPE OF SCREEN OR PERFORATION MATERIAL: X 7 PVC 10 Asbestos-cement
 1 Steel 3 Stainless steel 5 Fiberglass 8 RMP (SR) 11 Other (specify)
 2 Brass 4 Galvanized steel 6 Concrete tile 9 ABS 12 None used (open hole)
 SCREEN OR PERFORATION OPENINGS ARE: 5 Gauzed wrapped 8 Saw cut 11 None (open hole)
 1 Continuous slot X3 Mill slot 6 Wire wrapped 9 Drilled holes
 2 Louvered shutter 4 Key punched 7 Torch cut 10 Other (specify)
 SCREEN-PERFORATED INTERVALS: From . 114 ft. to . 134 ft., From . ft. to . ft.
 From . ft. to . ft., From . ft. to . ft.
 GRAVEL PACK INTERVALS: From . 25 ft. to . 134 ft., From . ft. to . ft.
 From . ft. to . ft., From . ft. to . ft.

6 GROUT MATERIAL: 1 Neat cement 2 Cement grout X 3 Bentonite 4 Other
 Grout intervals: From . 5 ft. to . 25 ft., From . ft. to . ft., From . ft. to . ft.
 What is the nearest source of possible contamination: 10 Livestock pens 14 Abandoned water well
 X 1 Septic tank 4 Lateral lines 7 Pit privy 11 Fuel storage 15 Oil well/Gas well
 2 Sewer lines 5 Cess pool 8 Sewage lagoon 12 Fertilizer storage 16 Other (specify below)
 3 Watertight sewer lines 6 Seepage pit 9 Feedyard 13 Insecticide storage
 Direction from well? EASP How many feet? 250

FROM	TO	LITHOLOGIC LOG	FROM	TO	PLUGGING INTERVALS
0	16	Top soil and sandy clay			
16	32	Cliche and fine sand			
32	49	Sand (medium) and little cliche			
49	65	Sand and little cliche			
65	82	Sand and cliche			
82	93	Sandy clay			
93	98	Fine sand			
98	114	Fine sand and cemented sand (little)			
114	120	Sand (medium) clean and loose			
120	125	Yellow clay			
125	132	Shale			

7 CONTRACTOR'S OR LANDOWNER'S CERTIFICATION: This water well was (1) constructed, (2) reconstructed, or (3) plugged under my jurisdiction and was completed on (mo/day/year) . August 12, 1994 . and this record is true to the best of my knowledge and belief. Kansas Water Well Contractor's License No. . 473 . This Water Well Record was completed on (mo/day/yr) . August 22, 1994 . under the business name of Tyler Water Well SVC. by (signature) *Dated [Signature]*

INSTRUCTIONS: Use typewriter or ball point pen. PLEASE PRESS FIRMLY and PRINT clearly. Please fill in blanks, underline or circle the correct answers. Send top three copies to Kansas Department of Health and Environment, Bureau of Water, Topeka, Kansas 66620-0001. Telephone: 913-296-5545. Send one to WATER WELL OWNER and retain one for your records.