


USE TYPEWRITER OR BALL POINT PEN-PRESS FIRMLY, PRINT CLEARLY.

WATER WELL RECORD
KSA 82a-1201-1215

Kansas Department of Health and Environment-Division of Environment (Water well Contractors) Topeka, Kansas 66620

35W

1. Location of well:		County Greeley	Fraction NW 1/4 NW 1/4 SE 1/4	Section number 28	Township number T 17 S	Range number R 42 E 10
2. Distance and direction from nearest town or city: 11W, 5 1/2 N, 1/2 W			3. Owner of well: Nick Lobmeyer			
Street address of well location if in city: of Tribune, Kansas			R.R. or street: Box 355			
			City, state, zip code: Tribune, KS 67879			
4. Locate with "X" in section below:		Sketch map:		6. Bore hole dia. <u>9</u> in. Completion date <u>8-31-76</u>		
N		E		Well depth <u>46</u> ft.		
W		S		7. <input type="checkbox"/> Cable tool <input checked="" type="checkbox"/> Rotary <input type="checkbox"/> Driven <input type="checkbox"/> Dug		
1 Mile		1 Mile		<input type="checkbox"/> Hollow rod <input type="checkbox"/> Jetted <input type="checkbox"/> Bored <input type="checkbox"/> Reverse rotary		
1 Mile		1 Mile		8. Use: <input type="checkbox"/> Domestic <input type="checkbox"/> Public supply <input type="checkbox"/> Industry		
1 Mile		1 Mile		<input type="checkbox"/> Irrigation <input type="checkbox"/> Air conditioning <input checked="" type="checkbox"/> Stock		
1 Mile		1 Mile		<input type="checkbox"/> Lawn <input type="checkbox"/> Oil field water <input type="checkbox"/> Other		
1 Mile		1 Mile		9. Casing: Material <u>Plas</u> Height <u>Above</u> or below		
1 Mile		1 Mile		Threaded <input type="checkbox"/> Welded <u>Glue</u> Surface <u>12</u> in.		
1 Mile		1 Mile		RMP <input checked="" type="checkbox"/> PVC <input type="checkbox"/> Weight <u>1.8</u> lbs./ft.		
1 Mile		1 Mile		Dia. <u>5</u> in. to <u>26</u> ft. depth Wall Thickness: inches or		
1 Mile		1 Mile		Dia. <u> </u> in. to <u> </u> ft. depth Gage No. <u>250</u>		
5. Type and color of material		From	To	10. Screen: Manufacturer's name <u>Jess & Lowell</u>		
Clay		0	26	Type <u>RMP</u> Dia. <u>5 in.</u>		
Fine sd		26	33	<input checked="" type="checkbox"/> gauze <u>1/16</u> Length <u>20 ft.</u>		
Sd coarse		33	42	Set between <u>26</u> ft. and <u>46</u> ft.		
Shale		<u>42</u>	46	ft. and <u> </u> ft.		
				Gravel pack? <u>Yes</u> Size range of material <u>1/4-1/8</u>		
				11. Static water level: <u>20</u> ft. below land surface Date <u>8-20-76</u>		
				12. Pumping level below land surfaces:		
				<u>30</u> ft. after <u>1</u> hrs. pumping <u>25</u> g.p.m.		
				ft. after <u> </u> hrs. pumping <u> </u> g.p.m.		
				Estimated maximum yield <u>25</u> g.p.m.		
				13. Water sample submitted: <u> </u> mo./day/yr.		
				Yes <input type="checkbox"/> No <input checked="" type="checkbox"/> Date <u> </u>		
				14. Well head completion:		
				<input checked="" type="checkbox"/> Pitless adapter <u>12</u> inches above grade		
				15. Well grouted? <u>yes</u>		
				With: <input checked="" type="checkbox"/> Neat cement <input type="checkbox"/> Bentonite <input type="checkbox"/> Concrete		
				Depth: From <u>0</u> ft. to <u>15</u> ft.		
				16. Nearest source of possible contamination: <u>In Feed</u>		
				ft. <u> </u> Direction <u> </u> Type <u>Lot</u>		
				Well disinfected upon completion? <input checked="" type="checkbox"/> Yes <input type="checkbox"/> No		
				17. Pump: <u> </u> Not installed		
				Manufacturer's name <u>Goulds</u>		
				Model number <u>EL</u> HP <u>1 1/2</u> Volts <u>230</u>		
				Length of drop pipe <u>42</u> ft. capacity <u>25</u> g.p.m.		
				Type:		
				<input checked="" type="checkbox"/> Submersible <input type="checkbox"/> Turbine		
				<input type="checkbox"/> Jet <input type="checkbox"/> Reciprocating		
				<input type="checkbox"/> Centrifugal <input type="checkbox"/> Other		
(Use a second sheet if needed)				20. Water well contractor's certification:		
18. Elevation:		19. Remarks:		This well was drilled under my jurisdiction and this report is true to the best of my knowledge and belief.		
Topography:		<u>TOPO 3760</u>		<u>Weishaar Drilling</u> <u>232</u>		
<input type="checkbox"/> Hill				Business name <u>Becht City, KS 67871</u> License No. <u> </u>		
<input type="checkbox"/> Slope				Address <u> </u> Date <u>9-7-76</u>		
<input type="checkbox"/> Upland				Signed <u> </u> Authorized representative		
<input checked="" type="checkbox"/> Valley				Date <u>9-7-76</u>		

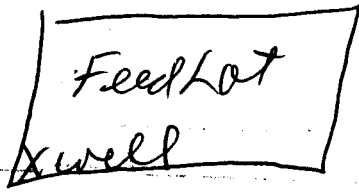

T 17
 R 42
 E 10
 Sec 28
 NW 1/4 SE 1/4