


1 LOCATION OF WATER WELL: Fraction NW 1/4 NE 1/4 NW 1/4 Section Number 2 Township Number T 17 S Range Number R 6

Distance and direction from nearest town or city street address of well if located within city?
4 miles North & 1/2 East of Langley, KS

2 WATER WELL OWNER: Norman Stofer
RR#, St. Address, Box #: 3102 E. 43rd Street
City, State, ZIP Code: Hutchinson, KS 67502
Board of Agriculture, Division of Water Resources
Application Number:

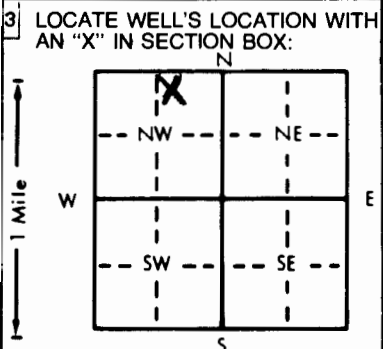

4 DEPTH OF COMPLETED WELL: 57 ft. ELEVATION: ...
Depth(s) Groundwater Encountered 1. 37 ft. 2. ... ft. 3. ... ft.
WELL'S STATIC WATER LEVEL: 37 ft. below land surface measured on mo/day/yr 4-10-11-89
Pump test data: Well water was ... ft. after ... hours pumping ... gpm
Est. Yield 4 gpm; Well water was 42 ft. after 1 hour pumping 4-5 gpm
Bore Hole Diameter: 8 in. to 57 ft., and ... in. to ... ft.
WELL WATER TO BE USED AS:
5 Public water supply 8 Air conditioning 11 Injection well
1 Domestic 3 Feedlot 6 Oil field water supply 9 Dewatering 12 Other (Specify below)
2 Irrigation 4 Industrial 7 Lawn and garden only 10 Monitoring well
Was a chemical/bacteriological sample submitted to Department? Yes... No... X...; If yes, mo/day/yr sample was submitted
Water Well Disinfected? Yes X No

5 TYPE OF BLANK CASING USED:
1 Steel 3 RMP (SR) 5 Wrought iron 8 Concrete tile CASING JOINTS: Glued ... Clamped ...
2 PVC 4 ABS 6 Asbestos-Cement 9 Other (specify below) Welded ...
7 Fiberglass ... Threaded ...
Blank casing diameter: 5 in. to 47 ft., Dia. ... in. to ... ft., Dia. ... in. to ... ft.
Casing height above land surface: 12 in., weight 2.91 lbs./ft. Wall thickness or gauge No. 265
TYPE OF SCREEN OR PERFORATION MATERIAL:
1 Steel 3 Stainless steel 5 Fiberglass 8 RMP (SR) 11 Other (specify) ...
2 Brass 4 Galvanized steel 6 Concrete tile 9 ABS 12 None used (open hole)
SCREEN OR PERFORATION OPENINGS ARE:
1 Continuous slot 3 Mill slot 5 Gauzed wrapped 8 Saw cut 11 None (open hole)
2 Louvered shutter 4 Key punched 6 Wire wrapped 9 Drilled holes
7 Torch cut 10 Other (specify) ...
SCREEN-PERFORATED INTERVALS: From 47 ft. to 57 ft., From ... ft. to ... ft.
GRAVEL PACK INTERVALS: From 20 ft. to 57 ft., From ... ft. to ... ft.

6 GROUT MATERIAL: 1 Neat cement 2 Cement grout 3 Bentonite 4 Other ...
Grout Intervals: From 0 ft. to 20 ft., From ... ft. to ... ft., From ... ft. to ... ft.
What is the nearest source of possible contamination:
1 Septic tank 4 Lateral lines 7 Pit privy 10 Livestock pens 14 Abandoned water well
2 Sewer lines 5 Cess pool 8 Sewage lagoon 11 Fuel storage 15 Oil well/Gas well
3 Watertight sewer lines 6 Seepage pit 9 Feedyard 12 Fertilizer storage 16 Other (specify below)
13 Insecticide storage
Direction from well? South How many feet? 300

| FROM | TO | LITHOLOGIC LOG | FROM | TO | PLUGGING INTERVALS |
|------|----|------------------|------|----|--------------------|
| 0 | 2 | Top Soil | | | |
| 2 | 33 | Clay | | | |
| 33 | 35 | Fine Sand | | | |
| 35 | 44 | Medium Sands | | | |
| 44 | 46 | Black Clay | | | |
| 46 | 51 | Light Blue Shale | | | |
| 51 | 55 | Red Shale | | | |
| 55 | 57 | Gray Shale | | | |

7 CONTRACTOR'S OR LANDOWNER'S CERTIFICATION: This water well was (1) constructed, (2) reconstructed, or (3) plugged under my jurisdiction and was completed on (mo/day/year) 4-11-89 and this record is true to the best of my knowledge and belief. Kansas Water Well Contractor's License No. 138 This Water Well Record was completed on (mo/day/yr) 9-14-89 under the business name of Peterson Irrigation, Inc. by (signature) Mike Peterson

OFFICE USE ONLY