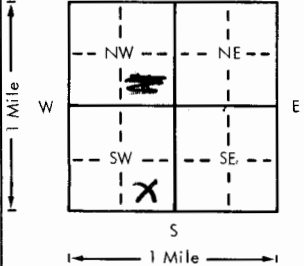


USE TYPEWRITER OR BALL
POINT PEN-PRESS FIRMLY,
PRINT CLEARLY.

WATER WELL RECORD
KSA 82a-1201-1215

Kansas Department of Health and
Environment-Division of Environment
(Water well Contractors)
Topeka, Kansas 66620

1. Location of well:		County ELLsworth	Fraction C-SE-1/4 SW 1/4 1/4 1/4	Section number 7	Township number T 17	Range number S R 9 E/W
2. Distance and direction from nearest town or city: Holyrood KS			3. Owner of well: L.D. Davis			
Street address of well location if in city: 2 1/2 East North side			R.R. or street:			
City, state, zip code: Shut Bend Kans						
X. Locate with "X" in section below:		Sketch map:		6. Bore hole dia. 7 in. Completion date 7-20-78 Well depth 90 ft.		
				7. ☐ Cable tool ☒ Rotary ☐ Driven ☐ Dug ☐ Hollow rod ☐ Jetted ☐ Bored ☐ Reverse rotary		
5. Type and color of material		From	To	8. Use: ☐ Domestic ☐ Public supply ☐ Industry ☐ Irrigation ☐ Air conditioning ☐ Stock ☐ Lawn ☒ Oil field water ☐ Other		
Clay		0	70	9. Casing: Material ☐ Height: Above or below Threaded ☐ Welded ☒ Surface 12 in. RMP ☐ PVC ☒ Weight 278-3 lbs./ft. Dia. 5 in. to 90 ft. depth Wall Thickness: inches or Dia. ☐ in. to ☐ ft. depth gage No. 200		
Sand Rock		70	90	10. Screen: Manufacturer's name Shop mach SAW Fessenden Type ☐ Dia. 5 Slot/gauze 1/8 Length 20 Set between 90 ft. and 70 ft. ☐ ft. and ☐ ft. Gravel pack? ☒ Size range of material 14-1/8		
				11. Static water level: ☐ mo./day/yr. 23 ft. below land surface Date 7-20-78		
				12. Pumping level below land surfaces: ☐ ft. after ☐ hrs. pumping ☐ g.p.m. ☐ ft. after ☐ hrs. pumping ☐ g.p.m. Estimated maximum yield ☐ g.p.m.		
				13. Water sample submitted: ☐ mo./day/yr. ☐ Yes ☒ No Date ☐		
				14. Well head completion: ☐ Pitless adapter 1 Inches above grade		
				15. Well grouted? ☒ With: ☐ Neat cement ☒ Bentonite ☐ Concrete Depth: From 0 ft. to 15 ft.		
				X. Nearest source of possible contamination None ft. ☐ Direction ☐ Type ☐		
				Well disinfected upon completion? ☒ Yes ☐ No		
				X. Pump: ☒ Not installed		
				Manufacturer's name ☐		
				Model number ☐ HP ☐ Volts ☐		
				Length of drop pipe ☐ ft. capacity ☐ g.p.m.		
				Type: ☐ Submersible ☐ Turbine ☐ Jet ☐ Reciprocating ☐ Centrifugal ☐ Other		
		(Use a second sheet if needed)				
18. Elevation:		19. Remarks:		20. Water well contractor's certification: This well was drilled under my jurisdiction and this report is true to the best of my knowledge and belief Moss Water Well 143 Business name ☐ License No. ☐ Address 1500 Broadway St. Bend Signed Royce Rosendall Date 7-20-78 Authorized representative		
Topography: ☐ Hill ☒ Slope ☐ Upland ☐ Valley						

Forward the white, blue and pink copies to the Department of Health and Environment

Form WWC-5