

1 LOCATION OF WATER WELL:		Fraction	Section Number		Township Number		Range Number	
County:	Ellsworth	SW 1/4 SW 1/4 SE 1/4	30		T 17 S		R 9 EW	


Distance and direction from nearest town or city street address of well if located within city?
Bushton 2E 1N

2	WATER WELL OWNER:	Geo Stump
	RR#, St. Address, Box # :	Bushton, Ks. 67427
	City, State, ZIP Code :	

Board of Agriculture, Division of Water Resources
Application Number: _____

3 LOCATE WELL'S LOCATION WITH AN "X" IN SECTION BOX:

4 DEPTH OF COMPLETED WELL... 53 ft. ELEVATION: Unknown

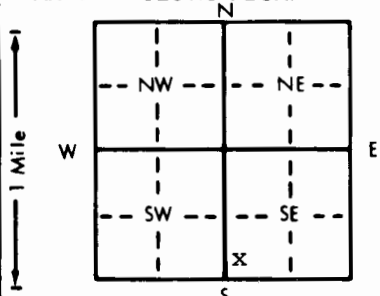

Depth(s) Groundwater Encountered 1. 19 ft. 2. ft. 3. ft.

WELL'S STATIC WATER LEVEL 19 ft. below land surface measured on mo/day/yr 9/22/89

Pump test data: Well water was ft. after hours pumping gpm

Est. Yield 25 gpm: Well water was ft. after hours pumping gpm

Bore Hole Diameter 8 in. to 53 ft., and in. to ft.

WELL WATER TO BE USED AS:

5 Public water supply	8 Air conditioning	11 Injection well
1 Domestic	3 Feedlot	6 Oil field water supply
2 Irrigation	4 Industrial	7 Lawn and garden only
		10 Monitoring well

12 Other (Specify below)

Was a chemical/bacteriological sample submitted to Department? Yes No^x; If yes, mo/day/yr sample was submitted

Water Well Disinfected? Yes No^x

5 TYPE OF BLANK CASING USED:		5 Wrought iron	8 Concrete tile	CASING JOINTS: Glued . ^x Clamped
1 Steel	3 RMP (SR)	6 Asbestos-Cement	9 Other (specify below)	Welded
2 PVC	4 ABS	7 Fiberglass		Threaded

Blank casing diameter 5 in. to 23 ft. Dia in. to ft. Dia in. to ft.
Casing height above land surface 12 in. weight 2.8 lbs./ft. Wall thickness or gauge No. Sch. 40

TYPE OF SCREEN OR PERFORATION MATERIAL:			7 <u>PVC</u>	10 Asbestos-cement
1 Steel	3 Stainless steel	5 Fiberglass	8 RMP (SR)	11 Other (specify)
2 Brass	4 Galvanized steel	6 Concrete tile	9 ABS	12 None used (open hole)

SCREEN OR PERFORATION OPENINGS ARE:		5 Gauzed wrapped	8 Saw cut	11 None (open hole)
1 Continuous slot	3 Mill slot	6 Wire wrapped	9 Drilled holes	
2 Louvered shutter	4 Key punched	7 Torch cut	10 Other (specify)	

SCREEN-PERFORATED INTERVALS:	From . . . 23	ft. to . . . 53	ft., From	ft. to	ft.
	From	ft. to	ft., From	ft. to	ft.
GRAVEL PACK INTERVALS:	From 20	ft. to . . . 53	ft., From	ft. to	ft.
	From	ft. to	ft., From	ft. to	ft.

6 GROUT MATERIAL: 1 Neat cement 2 Cement grout 3 Bentonite 4 Other
Grout Intervals: From 0 ft. to 20 ft. From ft. to ft. From ft. to ft.

What is the nearest source of possible contamination:			10 Livestock pens	14 Abandoned water well
1 Septic tank	4 Lateral lines	7 Pit privy	11 Fuel storage	15 Oil well/Gas well
2 Sewer lines	5 Cess pool	8 Sewage lagoon	12 Fertilizer storage	16 Other (specify below)
3 Watertight sewer lines	6 Seepage pit	9 Feedyard	13 Insecticide storage	No known source

Direction from well? ----- How many feet? -----

[illegible]

7 CONTRACTOR'S OR LANDOWNER'S CERTIFICATION: This water well was (1) constructed, (2) reconstructed, or (3) plugged under my jurisdiction and was completed on (mo/day/year) 9/22/89 and this record is true to the best of my knowledge and belief. Kansas Water Well Contractor's License No. 186 This Water Well Record was completed on (mo/day/yr) 10/16/89 under the business name of Kellie's Water Well by (signature) [Signature]