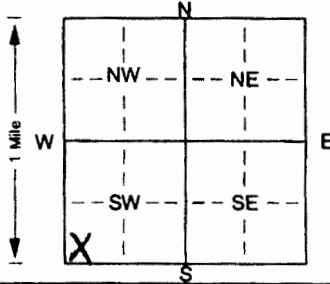


1 LOCATION OF WATER WELL: County: <u>Rice</u> Ellsworth		WATER WELL RECORD Fraction <u>SW 1/4 SW 1/4 SW 1/4</u>		TOWNSHIP NUMBER <u>31</u>		TOWNSHIP NUMBER T <u>17</u> S <u>8</u> R <u>9</u> E <u>(W)</u>	
Distance and direction from nearest town or city street address of well if located within city? <u>From Hwy 171 & Hwy 4 near Bushton, KS go E on Hwy 4 to 7th Rd N to A Ave. on NE corner</u>							
2 WATER WELL OWNER: <u>Kinder Morgan Attn: Scott Yount</u> RR#, St. Address, Box #: <u>1020 Hoover St.</u> City, State, ZIP Code: <u>Great Bend, KS 67530</u> 1 Well Board of Agriculture, Division of Water Resources Application Number: <u>N/A</u>							
3 LOCATE WELL'S LOCATION WITH AN "X" IN SECTION BOX:		4 DEPTH OF COMPLETED WELL: <u>27</u> ft. ELEVATION: _____					
		Depth(s) Groundwater Encountered 1. <u>19</u> ft. 2. _____ ft. 3. _____ ft. WELL'S STATIC WATER LEVEL _____ ft. below land surface measured on mo/day/yr Pump test data: Well water was _____ ft. after _____ hours pumping _____ gpm Est. Yield _____ gpm: Well water was _____ ft. after _____ hours pumping _____ gpm Bore Hole Diameter: <u>7</u> in. to <u>2.7</u> ft., and _____ in. to _____ ft. WELL WATER TO BE USED AS: 5 Public water supply 8 Air conditioning 11 Injection well 1 Domestic 3 Feedlot 6 Oil field water supply 9 Dewatering 12 Other (Specify below) 2 Irrigation 4 Industrial 7 Domestic (lawn & garden) <u>10 Monitoring well</u>					
Was a chemical/bacteriological sample submitted to Department? Yes. <u>No</u> ; If yes, mo/day/yr sample was submitted _____ Water Well Disinfected? Yes <u>No</u>							
5 TYPE OF BLANK CASING USED: 1 Steel 3 RMP (SR) 5 Wrought iron 8 Concrete tile CASING JOINTS: Glued. _____ Clamped. _____ <u>2 PVC</u> 4 ABS <u>2</u> 7 Fiberglass _____ Welded _____ Blank casing diameter _____ in. to _____ ft., Dia. _____ in. to _____ ft., Dia. _____ in. to _____ ft. Casing height above land surface: <u>30</u> in., weight <u>72</u> lbs./ft. Wall thickness or gauge No. <u>5 Sch 40</u> TYPE OF SCREEN OR PERFORATION MATERIAL: 1 Steel 3 Stainless steel 5 Fiberglass 8 RMP (SR) 10 Asbestos-cement 2 Brass 4 Galvanized steel 6 Concrete tile 9 ABS 11 Other (specify) _____ 12 None used (open hole) _____ SCREEN OR PERFORATION OPENINGS ARE: 1 Continuous slot <u>3 Mill slot</u> 5 Gauzed wrapped 8 Saw cut 11 None (open hole) 2 Louvered shutter 4 Key punched 6 Wire wrapped 9 Drilled holes 7 Torch cut 10 Other (specify) _____ SCREEN-PERFORATED INTERVALS: From <u>12</u> ft. to <u>27</u> ft., From _____ ft. to _____ ft. GRAVEL PACK INTERVALS: From <u>10</u> ft. to <u>27</u> ft., From _____ ft. to _____ ft.							
6 GROUT MATERIAL: 1 Neat cement 2 Cement grout <u>3 Bentonite</u> 4 Other <u>Concrete</u> Grout Intervals: From <u>0</u> ft. to <u>3</u> ft., From <u>3</u> ft. to <u>10</u> ft., From _____ ft. to _____ ft. What is the nearest source of possible contamination: 1 Septic tank 4 Lateral lines 7 Pit privy 10 Livestock pens 14 Abandoned water well 2 Sewer lines 5 Cess pool 8 Sewage lagoon 11 Fuel storage <u>15 Oil well/Gas well</u> 3 Watertight sewer lines 6 Seepage pit 9 Feedyard 12 Fertilizer storage 16 Other (specify below) _____ 13 Insecticide storage _____ Direction from well? <u>North</u> How many feet? <u>700</u>							
FROM TO LITHOLOGIC LOG		FROM TO PLUGGING INTERVALS					
0	25	Lt. Brown - Clay					
25	27	Gray - Shale					
7 CONTRACTOR'S OR LANDOWNER'S CERTIFICATION: This water well was <u>(1) constructed</u> , (2) reconstructed, or (3) plugged under my jurisdiction and was completed on (mo/day/year) <u>2/2/05</u> and this record is true to the best of my knowledge and belief. Kansas Water Well Contractor's Licence No. <u>676</u> This Water Well Record was completed on (mo/day/yr) <u>2/8/05</u> under the business name of <u>Whitetail Drilling, LLC</u> by (signature) <u>Andy Bards</u>							
INSTRUCTIONS: Use typewriter or ball point pen. PLEASE PRESS FIRMLY and PRINT clearly. Please fill in blanks, underline or circle the correct answers. Send top three copies to Kansas Department of Health and Environment, Bureau of Water, Topeka, Kansas 66620-0001. Telephone 785-296-5524. Send one to WATER WELL OWNER and retain one for your records. Fee of \$5.00 for each constructed well.							