

1	LOCATION OF WATER WELL:	Fraction	Section Number	Township Number	Range Number
	County: Ellsworth	NW ¼ NW ¼ SW ¼	32	T 17 S	R 9 EW

Distance and direction from nearest town or city street address of well if located within city?

2 East 1 North - Bushton, Kansas


2	WATER WELL OWNER: Kinder Morgan
---	---------------------------------

RR#, St. Address, Box # : 1020 Hoover St
City, State, ZIP Code : Great Bend, KS 67530

Board of Agriculture, Division of Water Resource
Application Number:

3 LOCATE WELL'S LOCATION WITH 4 DEPTH OF COMPLETED WELL 73 ft. ELEVATION:

AN "X" IN SECTION BOX:

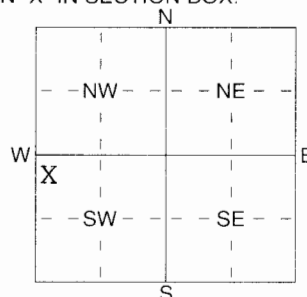

Depth(s) Groundwater Encountered 1 ft. 2 ft. 3 ft.
WELL'S STATIC WATER LEVEL 38.8 ft. below land surface measured on mo/day/yr 7/14/05

Pump test data: Well water was ft. after hours pumping gpm
 Est. Yield gpm: Well water was ft. after hours pumping gpm

WELL WATER TO BE USED AS:

1 Domestic	3 Feedlot	5 Public water supply	8 Air conditioning	11 Injection well
2 Irrigation	4 Industrial	6 Oil field water supply	9 Dewatering	12 Other (Specify below)
		7 Domestic (lawn & garden)	10 Monitoring well	Temp

Was a chemical/bacteriological sample submitted to Department? Yes No X..... If yes, mo/day/yr sample was submitted

Water Well Disinfected? Yes No X.....

5	TYPE OF BLANK CASING USED:
---	----------------------------

5 Wrought iron

8 Concrete tile

CASING JOINTS: Glued Clamped

1 Steel	3 RMP (SR)
2 PVC	4 ABS

6 Asbestos-Cement
7 Fiberglass

9 Other (specify below)

Welded

Blank casing diameter 2 in. to 53 ft. Dia _____ in. to _____ ft. Dia _____ in. to _____ ft.

Casing height above land surface 36 in., weight sch 40 lbs./ft. Wall thickness or guage No.

TYPE OF SCREEN OR PERFORATION MATERIAL:

1 Steel	3 Stainless Steel
2 Brass	4 Galvanized Steel

5 Fiberglass
6 Concrete tile

7-PVC

10 Asbestos-Cement

11 Other (Specify)

12 None used (open hole)

SCREEN OR PERFORATION OPENINGS ARE:

1 Continuous slot 3 Mill slot .010
2 Louvered shutter 4 Key punched

5 Guazed wrapped
6 Wire wrapped
7 Torch cut

8 Saw cut 11 None (open hole)
9 Drilled holes
10 Other (specify)

SCREEN-PERFORATED INTERVALS: From 73 ft. to 53 ft. From _____ ft. to _____ ft.

GRAVEL PACK INTERVALS:

10/20

6 GROUT MATERIAL: 1 Neat cement 2 Cement grout 3 Bentonite 4 Other.....

Grout Intervals: From 5.0 ft. to 0 ft., From 0 ft. to 0 ft., From 0 ft. to 0 ft.

What is the nearest source of possible contamination:

1 Septic tank	4 Lateral lines	7 Pit privy	11 Fuel storage	15 Oil well/Gas well
2 Sewer lines	5 Cess pool	8 Sewage lagoon	12 Fertilizer storage	16 Other (specify below)
3 Watertight sewer lines	6 Seepage pit	9 Feedyard	13 Insecticide storage	

Direction from well? West How many feet? 1/4 Mile West

[illegible]

7. CONTRACTOR'S OR LANDOWNER'S CERTIFICATION: This water well was (1) constructed, (2) reconstructed, or (3) plugged under my jurisdiction and was completed on (mo/day/year) 7/13/05 and this record is true to the best of my knowledge and belief. Kansas Water Well Contractor's Licence No. 665. This Water Well Record was completed on (mo/day/yr) 7/15/05 under the business name of Pratt Well Environmental by (signature) Steve Pratt