


ELLSWORTH

SE SE NW

Sec 31 T17S R9W

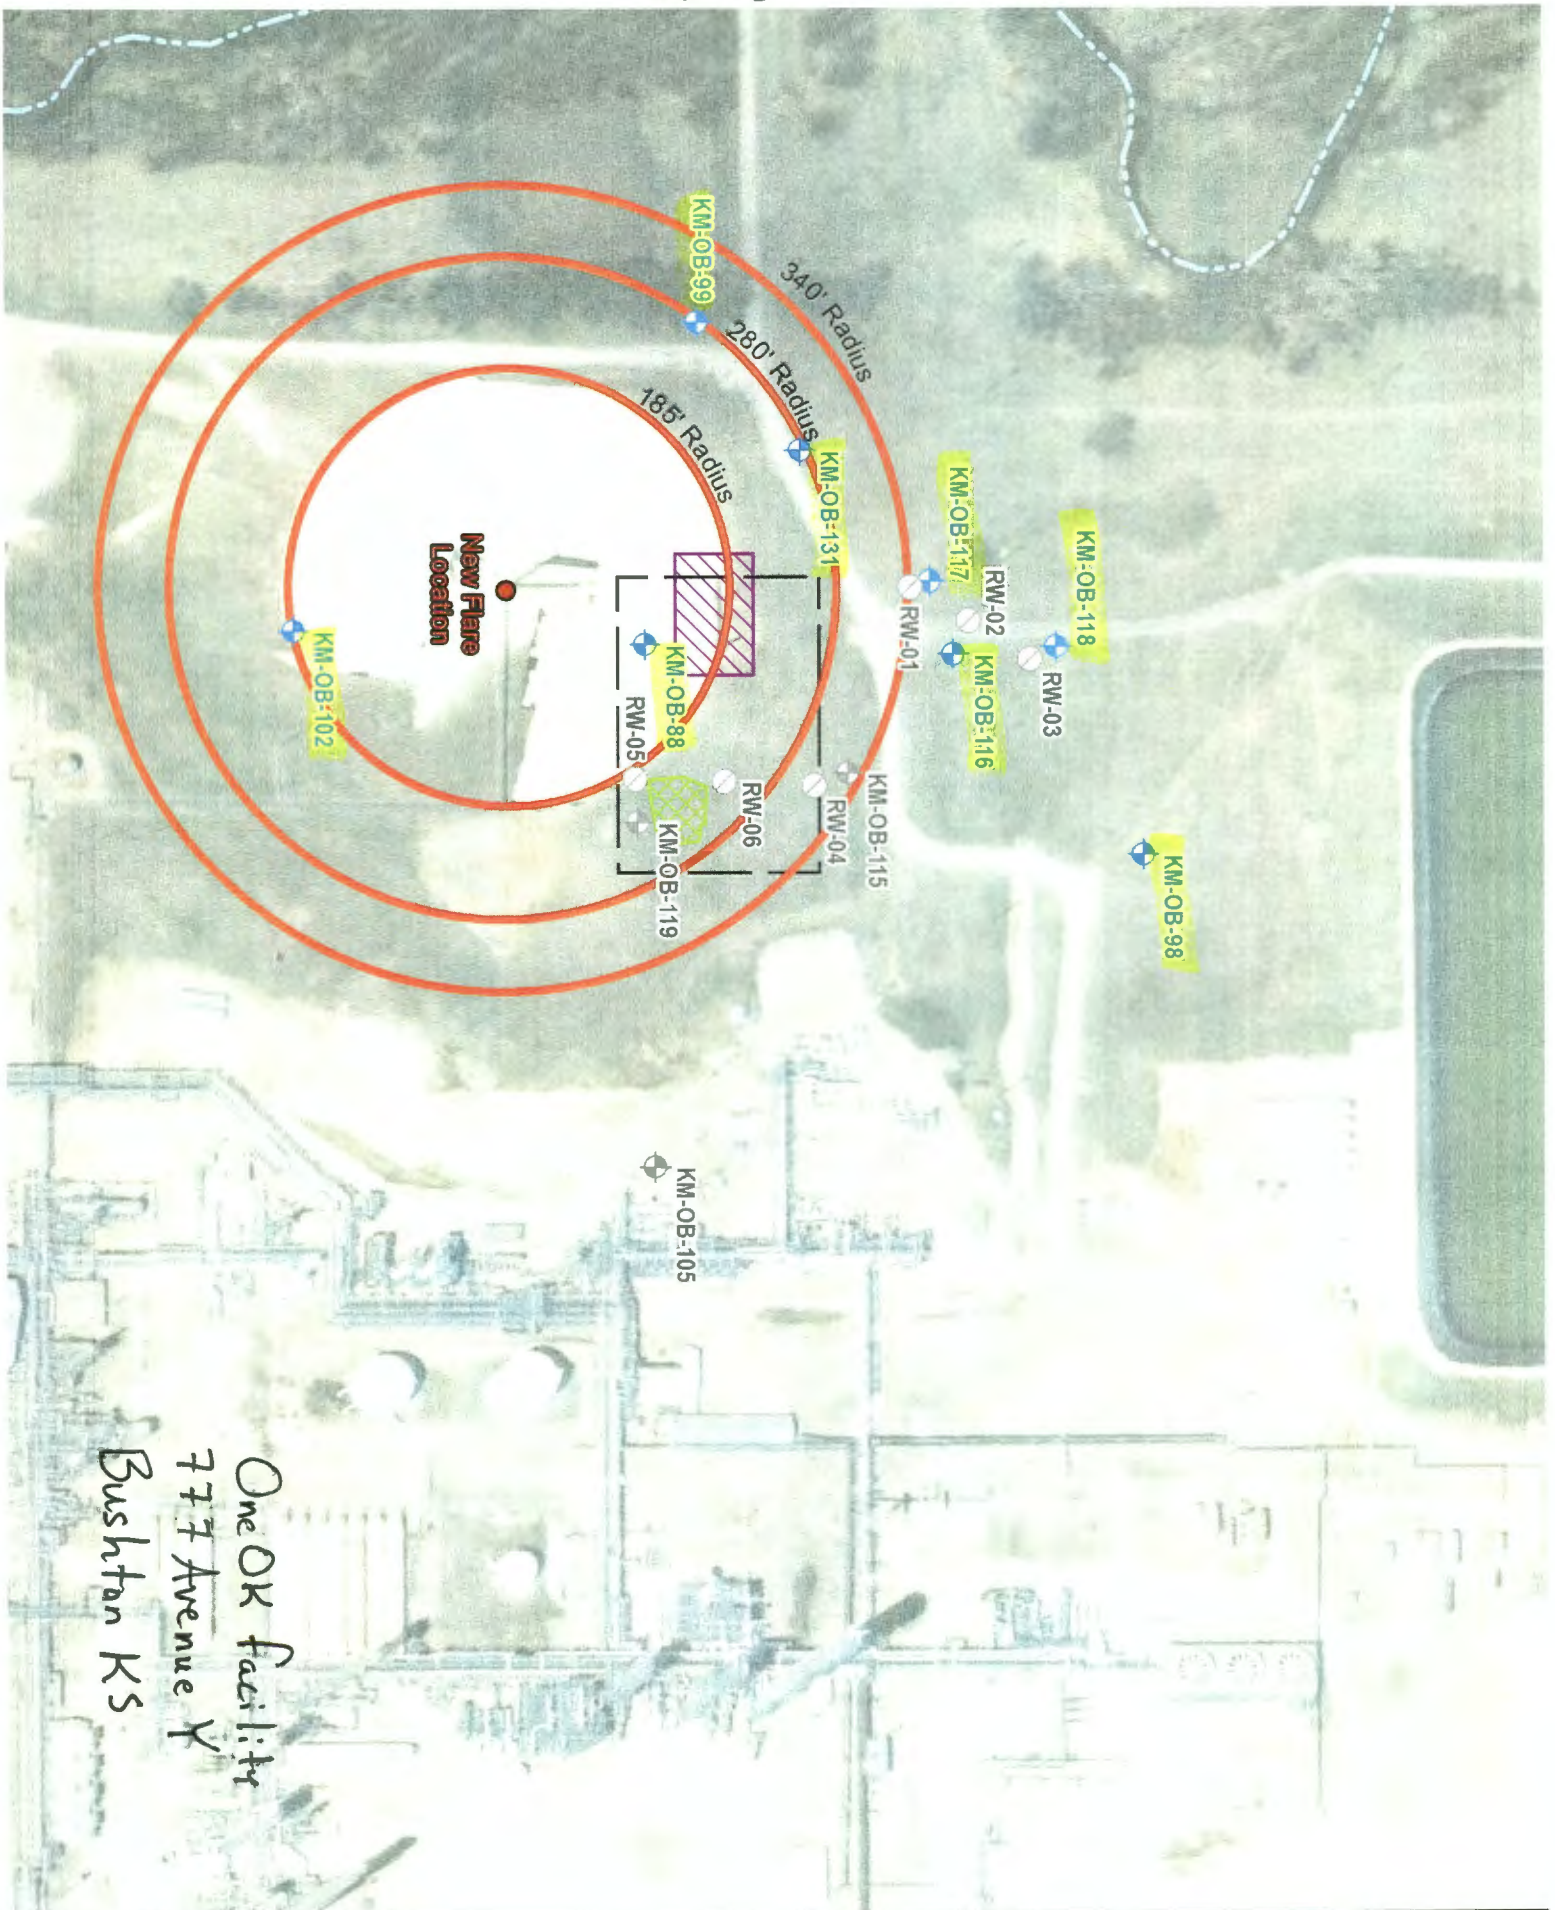

One OK facility
777 Avenue Y
Bushton KS

N

